

APR 05 1996

**LAND CORNER RECORDATION CERTIFICATE**  
 Filing Requirement of Act 74, Mich. P.A. 1970

For corners in **COMMISSION**  
WAYNE  
 (County)

Located in:	City of	Corner Code #
	Flat Rock	
1. Public Land Survey	T <u>4S</u> R <u>10E</u>	<u>C-13</u>
	T _____ R _____	_____
	T _____ R _____	_____
	T _____ R _____	_____
2. Property Controlling in Section	S _____ T _____ R _____	_____
	S _____ T _____ R _____	_____
3. Miscellaneous Property in Sec.	S _____ T _____ R _____	_____
	S _____ T _____ R _____	_____

**LIBER 28451 PAGE 497**


Compliance with  
 ACT 345, P.A. 1990

APPROVED ON: 11-28-95 *D.B.J.*  
**WAYNE COUNTY REMONUMENTATION**  
**PEER GROUP COMMITTEE**

Register of Deeds Stamp & File Number

Lot No. \_\_\_\_\_, Recorded Plat \_\_\_\_\_  
 Private Claims \_\_\_\_\_

Randy Kolehouse, in a field survey on September 7 19 94,  
 do hereby certify that under requirements of P.A. 74 Michigan P.A. of 1970, the corner points  
 mentioned in lines 1 and 2 above were in conformance with regulations and rules therefore as required  
 in the current manual of survey instructions of the United States Department of the Interior, Bureau of  
 Land Management or by a decree of a Court of Law and/or that the corner points mentioned in lines 3,  
 4 and 5 above were in conformance with the rules of the Michigan Board of Land Surveyors or by a  
 Decree of a Court of Law; established, re-established, monumented, re-monumented, recovered,  
 found as expressed below:

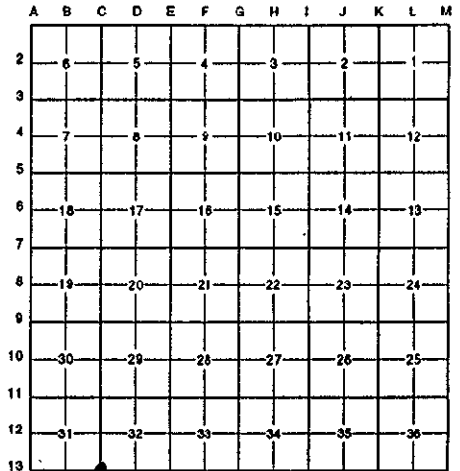

**NOTE: Not more than 4 corners, all in the same town and range, may be recorded on this certificate.**

Description of original monument and accessories and/or subsequent restoration:

Date	Description	Notes	Post
1817	G.L.O. Notes	N/A	Post
1930's	WPA Notes	N/A	Iron
1971	Cert. Survey L. P.	Carlson	CS #123
1973	WCRC Notes	N/A	Iron in Conc. Under 2" A.C. Cap

**\$ 4.00 REMONUMENTATION**  
**\$ 7.00 DEED**  
**8 DEC 95 12:37 P.M. RECEIPT**  
**RECORDED**  
**FOREST E. YOUNGBLOOD, REGISTER**  
**WAYNE COUNTY, MI**

45262452 EDS

Description of corner evidence found and/or method applied in restoring or reestablishing corner:

13 I found 1/2" pipe in monument box at C/L of Gibraltar Road (asphalt) which agrees with the following.

WPA	WCRC
E.D. Guy Pole SW 67.89'	Nail & Tag D.E. Pole SE'y 67.95' (67.96' m)
Iron West 110.10'	C/L Top Bolt Hyd. NE'y 44.78' (44.66' m)
	Iron NW Cor. Sec. 5 T5S R10E West 110.20' (110.37' m)

Measures East to D-13 = 2684.4' (G.L.O. = 2640') (WPA = 2636.83') (CS #123 = 2636.81')  
 Measures West to C-1 T5S R10E = 110.37' (G.L.O. = 110.22') (WPA = 110.10')

Description of monument for corner and accessories established to perpetuate locating the position of the corner:

13 I replaced the 1/2" pipe with 1/2" rebar & aluminum cap stamped "Wayne Co. Remon." in an existing monument

- C/L Top Nut Hyd. N 16° E 44.66'
- Nail w/Tag "WCRC" N Face Util. Pole S 46° E 67.96'
- PK w/Shinner NW Face 12" Maple S 38° W 48.55'
- SE Cor. Bldg. #25730 Gibraltar Road N R/W 95.13'

*NOT A COMMON CORNER*



The selected location is accepted by the Contractor and is generally accepted by professional surveyors as the best available evidence of the position of the original corner.

Signed by Randy J. Kolehouse  
 Surveyor's Michigan License No. 25854

Date 12/2/95

4R  
7D  
P