

FILE DO NOT MAIL

LAND CORNER RECORDATION CERTIFICATE
Filing Requirement of Act 74, Mich. P.A. 1970

L 29743 P 2385

For corners in **SECTION**

| WAYNE (County) | Located in: Brownstown Township | Corner Code # |
|---------------------------------------|------------------------------------|---------------|
| 1. Public Land Survey | T <u>4S</u> R <u>10E</u> | <u>D-3</u> |
| | T _____ R _____ | _____ |
| | T _____ R _____ | _____ |
| | T _____ R _____ | _____ |
| 2. Property Controlling in Section | S _____ T _____ | _____ |
| | S _____ T _____ | _____ |
| 3. Miscellaneous Property in Sec. | S _____ T _____ | _____ |
| | S _____ T _____ | _____ |
| 4. Lot No. _____, Recorded Plat _____ | | |
| 5. Private Claims _____ | | |


Compliance with
ACT 345, P.A. 1990

APPROVED ON: 12-1-97 *DBJ*

WAYNE COUNTY REMONUMENTATION
PEER GROUP COMMITTEE
Register of Deeds Stamp & File Number

I, Randy Kolehouse, in a field survey on November 6 19 97, do hereby certify that under requirements of P.A. 74 Michigan P.A. of 1970, the corner points mentioned in lines 1 and 2 above were in conformance with regulations and rules therefore as required in the current manual of survey instructions of the United States Department of the interior, Bureau of Land Management or by a decree of a Court of Law and/or that the corner points mentioned in lines 3, 4 and 5 above were in conformance with the rules of the Michigan Board of Land Surveyors or by a Decree of a Court of Law; established, re-established, monumented, re-monumented, recovered, found as expressed below:

NOTE: Not more than 4 corners, all in the same town and range, may be recorded on this certificate.

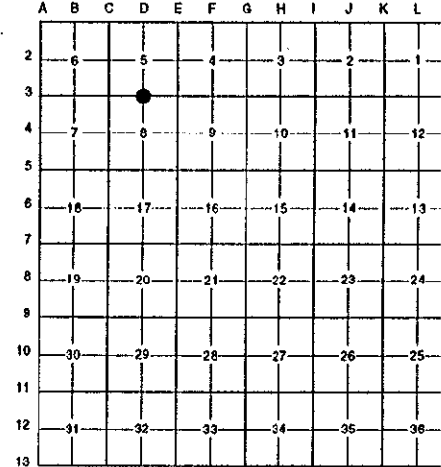

A. Description of original monument and accessories and/or subsequent restoration:

| D-3 | 1. 1817 | G.L.O. | Fletcher | Notes | Post |
|-----|-----------|--------------|---------------------|----------------------|-------------------------------------|
| | 2. 1930's | WPA Notes | N/A | Section Map and Ties | Iron |
| | 3. 1973 | W.C.R.C. | Coon | Witness Record | Monument in Box |
| | 4. 1974 | L.C.R.C. | Landini #16933 | L. 18772 P. 24 | 1/2" Iron Pipe |
| | 5. 1974 | Cert. Survey | Landini #16933 | L. 18772 P. 19-20 | 1/2" Iron Pipe |
| | 6. 1976 | W.C.R.C. | Lopota | | 1/2" Steel Rod in Conc. Cyl. in Box |
| | 7. 1976 | MDSH Wits. | Swieboda | | 1/2" Pipe in Mon Box |
| | 8. 1996 | L.C.R.C. | Sandomierski #24616 | L. 28753 P. 313 | Conc. Mon. in Box |

B. Description of corner evidence found and/or method applied in restoring or reestablishing corner:

D-3 Found a concrete monument in a monument box 7' North of the C/L of Sibley Road (asph.) running East and West per the following witnesses:

\$4.00 REMONUMENTATION

"+" NW rim GV&W, M= S35E 64.89', R= 64.96' (3, 6 & 7): Nail w/MDSH tag SE face util pole, M= S50W 71.94', R= 72.00' (6 & 7), 72.05' (8): Center top nut hydrant, M= S65W 85.74', R= 85.74' (6), 85.80' (8): Nail w/tag W face util pole, M= N2E 33.25', R= 33.26': PK w/WCRC tag E face util pole, M= N2E 32.95', R= 32.89' (3, 6 & 7), 32.95' (8), 32.88' (5).

RECORDED
FOREST E. YOUNGBLOOD, REGISTER OF D
WAYNE COUNTY, MI
Receipt #43169

Measure West to C-3 = 2640.24' (WPA = 2640.04') (G.L.O. = 2641.98')
Measure East to E-3 = 2637.12' (WPA = 2637.68') (G.L.O. = 2641.98') (MDSH = 2637.14')

C. Description of monument for corner and accessories established to perpetuate locating the position of the corner:

D-3 Placed a 2" diameter aluminum cap stamped "Wayne Co. Remon. #25854" on an existing 4" x 36" concrete monument in an existing monument box.

\$7.00 DEED

60d Nail in S Side 36" Oak N 88° E 142.49'
"+" NW Rim G.V. & W S 38° E 64.89'
P.K. Nail w/#14864 Tag in W Side 20" Oak S 03° E 75.66'
Nail w/MDSH Tag in SE Face Util. Pole S 50° W 71.94'

C/L Top Nut Hydrant S 65° W 85.74'
Nail w/Tag #19397 in W Face Util. Pole N 02° E 33.25'
P.K. Nail w/W.C.R.C. Tag in E Face Util. Pole N 02° E 32.95'

The selected location is accepted by the Contractor and is generally accepted by professional surveyors as the best available evidence of the position of the original corner.

Signed by Randy J. Kolehouse Date 12/16/97
Surveyor's Michigan License No. 25854

