

FILE DO NOT MAIL

LAND CORNER RECORDATION CERTIFICATE
Filing Requirement of Act 74, Mich. P.A. 1970

SURVEY & REMONUMENTATION

MAR 17 1998

For corners in

WAYNE (County)	Located in: Brownstown Township	Corner Code #
1. Public Land Survey	T <u>4S</u> R <u>10E</u>	<u>D-5</u>
	T _____ R _____	_____
	T _____ R _____	_____
	T _____ R _____	_____
2. Property Controlling in Section	S _____ T _____ R _____	_____
	S _____ T _____ R _____	_____
3. Miscellaneous Property in Sec.	S _____ T _____ R _____	_____
	S _____ T _____ R _____	_____

SECTION


Compliance with
ACT 345, P.A. 1990

APPROVED ON: 12-1-97 *DP*
WAYNE COUNTY REMONUMENTATION
PEER GROUP COMMITTEE
Register of Deeds Stamp & File Number

4. Lot No. _____, Recorded Plat _____
5. Private Claims _____

I, Randy Kolehouse, in a field survey on November 5 19 97, do hereby certify that under requirements of P.A. 74 Michigan P.A. of 1970, the corner points mentioned in lines 1 and 2 above were in conformance with regulations and rules therefore as required in the current manual of survey instructions of the United States Department of the interior, Bureau of Land Management or by a decree of a Court of Law and/or that the corner points mentioned in lines 3, 4 and 5 above were in conformance with the rules of the Michigan Board of Land Surveyors or by a Decree of a Court of Law; established, re-established, monumented, re-monumented, recovered, found as expressed below:

NOTE: Not more than 4 corners, all in the same town and range, may be recorded on this certificate.

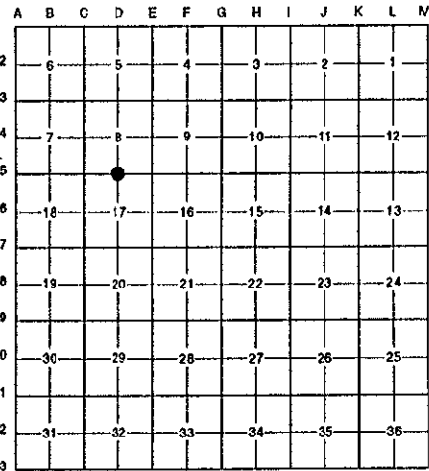

A. Description of original monument and accessories and/or subsequent restoration:

D-5	1. 1817 G.L.O.	Fletcher	Notes	Post
	2. 1930's WPA Notes	N/A	Section Map and Ties	Iron
	3. 1973 W.C.R.C.	Coon	Witness Records	1" Pipe w/ 1/2" Pipe Bent 2.28' ESE
	4. 1987 DECO	Vaderna	Survey/Wits.	3/4" Iron Rod

\$7.00 DEED

B. Description of corner evidence found and/or method applied in restoring or reestablishing corner:

D-5 Found a 3/4" rod 3' South of the C/L of King Road (gravel) running East and West per the following witnesses:

PK w/tag N face util pole, M= S4W 32.67', R= 32.74" (4): "+" NE rim sanitary manhole, M=S51W 72.24', R= 73.00' ((3): "+" NE rim sanitary manhole, M= S79W 80.24', R= 80.10' (3): Center top nut hydrant, M= N47W 76.80', R= 76.35' (3), 76.81' (4).

\$4.00 REMONUMENTATION
RECORDED
FOREST E. YOUNGLOOD, REGISTER OF DEEDS
WAYNE COUNTY, MI
Receipt #43169

Measure West to C-5 = 2573.81' (WPA = 2573.67') (G.L.O. = 2640.00')
Measure East to E-5 = 2641.29' (WPA = 2641.47') (G.L.O. = 2640.00') (DECO = 2641.54')

C. Description of monument for corner and accessories established to perpetuate locating the position of the corner:

D-5 Replaced an existing 3/4" rod with a 4" x 36" concrete monument with a 2" diameter aluminum cap stamped "Wayne Co. Remon. #25854."

60d Nail in W Face 10" Tree N 11° E 31.63'
Nail w/W.C.R. Tag in SE Face Util. Pole N 65° E 107.67'
Nail w/W.C.R. Tag in N Face Util. Pole S 73° E 158.37'
Nail w/W.C.R. Tag in E Face Util. Pole S 04° W 33.04'

"+" NE Rim San. M/H S 51° W 72.24'
"+" NE Rim San. M/H S 70° W 80.24'
C/L Top Nut Hydrant N 47° W 76.80'



The selected location is accepted by the Contractor and is generally accepted by professional surveyors as the best available evidence of the position of the original corner.

Signed by Randy J. Kolehouse Date 12/15/97
Surveyor's Michigan License No. 25854

DP