

FILE DO NOT MAIL

SURVEY & REMONUMENTATION
LAND CORNER RECORDATION CERTIFICATE
Filing Requirement of Act 74, Mich. P.A. 1970

For corners in

WAYNE
(County)

Located in: Brownstown Township Corner Code # _____

1. Public Land Survey	T <u>4S</u> R <u>10E</u>	<u>D-7</u>
	T _____ R _____	_____
	T _____ R _____	_____
	T _____ R _____	_____
2. Property Controlling in Section	S _____ T _____ R _____	_____
	S _____ T _____ R _____	_____
3. Miscellaneous Property in Sec.	S _____ T _____ R _____	_____
	S _____ T _____ R _____	_____
4. Lot No. _____, Recorded Plat _____		
5. Private Claims _____		

MAR 17 1998


SECTION

Compliance with
ACT 345, P.A. 1990

APPROVED ON: 12-1-97 *DBJ*
WAYNE COUNTY REMONUMENTATION
PEER GROUP COMMITTEE
Register of Deeds Stamp & File Number

I, Randy Kolehouse, in a field survey on November 5 19 97, do hereby certify that under requirements of P.A. 74 Michigan P.A. of 1970, the corner points mentioned in lines 1 and 2 above were in conformance with regulations and rules therefore as required in the current manual of survey instructions of the United States Department of the interior, Bureau of Land Management or by a decree of a Court of Law and/or that the corner points mentioned in lines 3, 4 and 5 above were in conformance with the rules of the Michigan Board of Land Surveyors or by a Decree of a Court of Law; established, re-established, monumented, re-monumented, recovered, found as expressed below:

NOTE: Not more than 4 corners, all in the same town and range, may be recorded on this certificate.

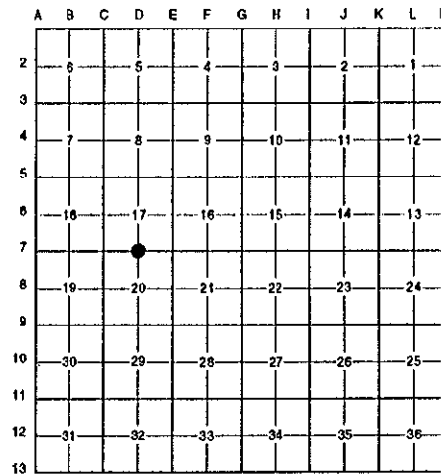

A. Description of original monument and accessories and/or subsequent restoration:

D-7	1. 1817	G.L.O.	Fletcher	Notes	Post
	2. 1930's	WPA Notes	N/A	Section Map and Ties	Iron
	3. N/A	Plat	N/A	L. 44 P. 57	N/A
	4. N/A	Plat	N/A	L. 102 P. 55	N/A
	5. 1973	W.C.R.C.	Coon	Witness Records	1" Iron Pipe
	6. 1978	Cert. Survey	Crossman #9428	L. 20378 P. 62-63	Iron Pipe
	7. 1987	L.C.R.C.	Patterson #17631	L. 23534 P. 21	Monument in Hand Hole
	8. 1987	DECO	Vaderna #25878	Survey/Wits.	Monument in Hand Hole
	9. 1990	Plat	Fraus #17089	L. 103 P. 51	N/A

B. Description of corner evidence found and/or method applied in restoring or reestablishing corner:

D-7 Found a 1/2" rebar in a concrete monument in a monument box 120' ± West of the C/L intersection of West Road (asph.) running East and West and Sylvan Drive (conc.) running North per the following witnesses:

Center top nut hydrant, M= N50E 133.08', R= 133.20' (7), 133.12' (8): "+" NW rim sanitary manhole, M= S53E 77.29', R= 77.34' (5), 77.90' (7, N rim): Center top nut hydrant, M= S63W 76.67', R= 76.74' (5), 76.90' (6, "x" on flange), 76.80' (7), 76.68' (8).

Measure West to C-7 = 2633.87' (WPA = 2633.72') (G.L.O. = 2640.00')
Measure East to E-7 = 2582.66' (WPA = 2582.33') (G.L.O. = 2640.00') (DECO = 2582.64') (Fraus = 2582.70')

C. Description of monument for corner and accessories established to perpetuate locating the position of the corner:

D-7 Set a 2" diameter aluminum cap stamped "Wayne Co. Remon. #25854" on an existing 4" x 36" concrete monument in an existing monument box.


C/L Top Nut Hyd. N 50° E 133.08'
Nail w/W.C.R. Tag in SE Face Util. Pole N 77° E 164.64'
"+" NW Rim San. M/H S 53° E 77.29'
C/L Top Nut Hyd. S 63° W 76.67'
Nail w/W.C.R. Tag in E Face Util. Pole N 26° W 61.87'

The selected location is accepted by the Contractor and is generally accepted by professional surveyors as the best available evidence of the position of the original corner.

Signed by Randy J. Kolehouse Date 12/16/97
Surveyor's Michigan License No. 25854

\$7.00 DEED

\$4.00 REMONUMENTATION
RECORDED
FOREST E. YOUNGBLOOD, REGISTER OF DEEDS
WAYNE COUNTY, MI
Receipt #43169

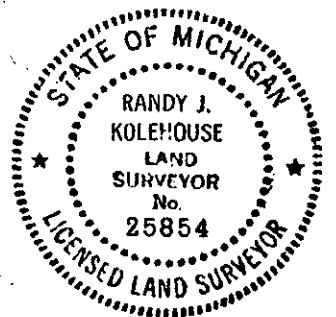

DBJ