

FILE DO NOT MAIL

LAND CORNER RECORDATION CERTIFICATE
Filing Requirement of Act 74, Mich. P.A. 1970

For corners in

Table with columns: Wayne (County), Located In: City of Flat Rock, Corner Code #, and survey details for Public Land Survey, Property Controlling, and Miscellaneous Property.

Liber-30864 Page-13
99595585 12/30/1999
F.E. Youngblood, Wayne Co. Register of Deeds


Compliance with
ACT 345, P.A. 1990

APPROVED ON: 12-8-99
WAYNE COUNTY REMONUMENTATION
PEER GROUP COMMITTEE

Register of Deeds Stamp & File
Number

4. Lot No. , Recorded Plat
5. Private Claims

I, Michael S. Hoben, in a field survey on Sept. 16, 1999, do hereby state that under requirements of P.A. 74, Michigan P.A. of 1970, the corner points mentioned in lines 1 and 2 above were in conformance with regulations and rules therefore as required in the current manual of survey instructions of the United States Department of the Interior, Bureau of Land Management or by a decree of a Court of Law and/or that the corner points mentioned in lines 3, 4 and 5 above were in conformance with the rules of the Michigan Board of Land Surveyors or by a Decree of a Court of Law; established, re-established, monumented, recovered, found as expressed below:

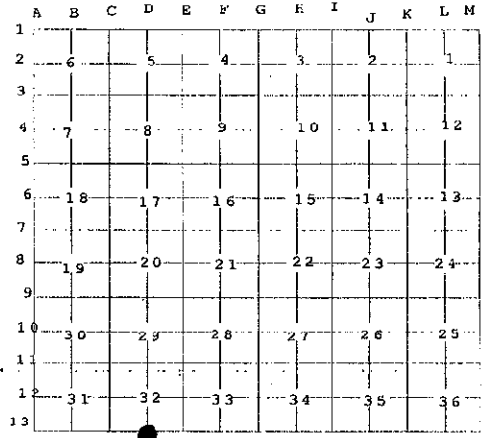

NOTE: Not more than 2 corners, all in the same town and range, may be recorded on this certificate.

A. Description of original monument and accessories and/or subsequent restoration:

D-13 1817 GLO Notes Preston
N/A Post
1930's WPA witnesses Set cross
1930's WPA dimensions
Huron Drive Estates No. 3
1973 WCRC
1971 LCRC L. 18022, P. 31 William G. Carlson 14759 Found cross under asph.
1998 LCRC L. 29917, P. 49 Thaddeus A. Wozniak 15066 Set PK nail
Punch hole CL empty mon. box

B. Description of corner evidence found and/or method applied in restoring or reestablishing corner:

D-13 I found an empty monument box with a punch hole in the center of the lid on the centerline of Gibraltar RD. (asph.). Which agrees with the following witnesses:

Util. Pole to the north 33.12'M (33.55'WCRC, 33.11'LCRC'98)
Util pole to NW89.96'M (WCRC = 90.03')
PK west 209.94'M (WCRC = 209.61')
Util. Pole to the SW.35.80'.(LCRC'98 = 35.71')

Distance to C-13 = 2637.42' (GLO = 2640')(WPA = 2636.83')
Distance to E-13 = 2652.44' (GLO = 2640')(WPA = 2652.62')
Distance to D-1 T5SR10E = 209.94' (WPA = 209.95')
(over)

C. Description of monument for corner and accessories established to perpetuate locating the position of the corner:

D-13 I set a rebar with a 2" aluminum cap stamped "Wayne County Monument MI Act 345, 35994" in the existing mon. box.

N 70° E 113.20' Set nail w/WCRemon tag W'ly face Util. pole
S 15° W 35.80' FD. Nail w/WCRC tag NE'ly face Util. pole
S 60° W 80.96' FD. "+" NE corner conc. headwall
N 65° W 89.96' FD. Nail w/WCRC tag SW'ly face Util. Pole
N 1° W 33.12' FD. Nail w/WCRC tag SW'ly face Util. Pole
West 209.94' to D-1 T5S, 10E



This is not a common corner.

The selected location is accepted by me and is generally accepted by Professional Surveyors as the best available evidence of the position of the original corner.

Signed by Michael S. Hoben
Surveyor's Michigan License No. 35994

Date Feb 27, 1999

FORM APPROVED BY MICHIGAN STATE BOARD OF LAND SURVEYORS, JAN. 28, 1971

REVISED MAY 14, 1975
REVISED JAN., 1983
REVISED OCT., 1999

R LCR 12 4 R 2 Pgs A

WPA with 1930

"X" in conc.

NE 33.35' DE pole (gone)

NW 90.03' DE pole

SE 90.70' tree (gone)

Liber-30864

Page-14

SW 49.25' 32" Locust tree (gone)

SW 88.93' "X" in 1' W OF E end of parapet wall (gone)

W 209.61' to D-1

LCRC 1972

Set P.K. nail

N2W 32.60' to P.K. nail in DE pole

S40E 38.00' to P.K. nail in MBT pole (gone)

S48W 47.00' to P.K. nail in 36" tree (gone)

WCRC witnesses 1973

FD. "X" in conc.

NE 33.55' to P.K. nail in DE pole (gone)

SE 90.70' tree (gone)

SW 47.79' Locust tree (gone)

SW 88.93' "X" in 1' W OF E end of parapet wall (gone)

W 209.61' D-1

NW 90.03' to P.K. nail in DE pole

LCRC witnesses 1998

N70E 109.85' to P.K. nail in DE pole

Fd. S45E 141.35' to P.K. nail in MBT pole

FD. S10W 35.71' to P.K. w/washer (WC)

N20W 33.11' to P.K. w/washer

RF

FEB 28 2000

SECTION