

**FILE DO NOT MAIL**

**SURVEY & REMONUMENTATION**  
**LAND CORNER RECORDATION CERTIFICATE**  
Filing Requirement of Act 74, Mich. P.A. 1970

MAR 17 1998

For corners in

WAYNE  
(County)

Located in: Brownstown Township Corner Code #

1. Public Land Survey	T <u>4S</u>	R <u>10E</u>	<u>E-2</u>
	T _____	R _____	_____
	T _____	R _____	_____
	T _____	R _____	_____
2. Property Controlling in Section	S _____	T _____	R _____
	S _____	T _____	R _____
3. Miscellaneous Property in Sec.	S _____	T _____	R _____
	S _____	T _____	R _____

4. Lot No. \_\_\_\_\_, Recorded Plat \_\_\_\_\_


5. Private Claims \_\_\_\_\_

SECTION

Compliance with  
ACT 345, P.A. 1990

APPROVED ON: 12-1-97 *DPJ*  
WAYNE COUNTY REMONUMENTATION  
PEER GROUP COMMITTEE  
Register of Deeds Stamp & File Number

I, Randy Kolehouse, in a field survey on November 5 19 97, do hereby certify that under requirements of P.A. 74 Michigan P.A. of 1970, the corner points mentioned in lines 1 and 2 above were in conformance with regulations and rules therefore as required in the current manual of survey instructions of the United States Department of the interior, Bureau of Land Management or by a decree of a Court of Law and/or that the corner points mentioned in lines 3, 4 and 5 above were in conformance with the rules of the Michigan Board of Land Surveyors or by a Decree of a Court of Law; established, re-established, monumented, re-monumented, recovered, found as expressed below:

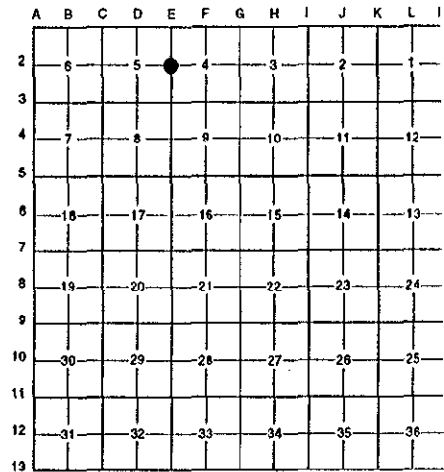

NOTE: Not more than 4 corners, all in the same town and range, may be recorded on this certificate.

A. Description of original monument and accessories and/or subsequent restoration:

E-2	1817	G.L.O.	Fletcher	Notes	\$7.00 DEED
	1925	Plat	Cautor	L. 55 P. 36	Post Monument
	1930's	WPA Notes	N/A	Section Map and Ties	Iron?
	1972	L.C.R.C.	Cantrell #5782	L. 18296 P. 912-913	Mon. in Hand Hole
	1972	Cert. Survey	Cantrell #5782	L. 18296 P. 111	Mon. in Hand Hole
	1973	W.C.R.C.	Coon	Witness Record	Mon. in Box
	1973	Cert. Survey	Stanley #12031	L. 18387 P. 787-788	N/A
	1973	L.C.R.C.	Crossman #9428	L. 18715 P. 734	Mon. in Hand Hole
	1974	L.C.R.C.	Landini #16933	L. 18772 P. 28	1/2" Iron Pipe
	1974	Cert. Survey	Landini #16933	L. 18772 P. 19-20	1/2" Iron Pipe
	1974	Cert. Survey	Arthurs #11358	L. 18912 P. 381	N/A
	1976	MDSH	Swieboda	Witness Card	1/2" Iron in Mon Box

B. Description of corner evidence found and/or method applied in restoring or reestablishing corner:

E-2 Found a concrete monument in a monument box 60' ± South of the C/L intersection of Telegraph Road (asph.) running North and South and Crawford Road (gravel) running East per the following witnesses:

Although some witnesses found were within one or two feet, I don't believe any to be the same witnesses as recorded. None had WCRC tags. It appears that all have been replaced. However, the distances measured match those of WPA and MDSH and I believe this to be the same corner found on the above records.

\$4.00 REMONUMENTATION  
RECORDED  
FOREST E. YOUNGBLOOD, REGISTER OF DEEDS  
WAYNE COUNTY, MI  
Receipt #43169

C. Description of monument for corner and accessories established to perpetuate locating the position of the corner:

E-2 Set a 2" diameter aluminum cap stamped "Wayne Co. Remon. #25854" on an existing 4" x 36" concrete monument in an existing monument box.

- Nail w/W.C.R. Tag in S Face Util. Pole N 66° E 100.71'
- P.K. Nail in S Face Util. Pole N 83° E 34.52'
- P.K. Nail in W Face Util. Pole S 10° E 149.28'
- P.K. Nail in E Face Util. Pole S 25° W 106.52'
- P.K. Nail in E Face Util. Pole N 30° W 55.57'

The selected location is accepted by the Contractor and is generally accepted by professional surveyors as the best available evidence of the position of the original corner.

Signed by Randy Kolehouse Date 12/16/97  
Surveyor's Michigan License No. 25854

