

**SURVEY & REMONUMENTATION**

APR 25 1995

**COMMISSION**

**RC 1601**

\$ 13.00 MISCELLANEOUS RECORDING  
28 DEC 94 9:41 A.M. RECEIVED

**LAND CORNER RECORDATION CERTIFICATE**  
Filing Requirement of Act 74, Mich. P.A. 1970

RECORDED  
FOREST E. YERGENSON, REGISTERED PROFESSIONAL SURVEYOR  
WAYNE COUNTY, MI

For corners in

<u>WAYNE</u> (County)	Located in: <u>Brownstown</u> Township	Corner Code #
1. Public Land Survey	T <u>4S</u> R <u>10E</u>	<u>E-3</u>
	T _____ R _____	_____
	T _____ R _____	_____
	T _____ R _____	_____
2. Property Controlling in Section	S _____ T _____ R _____	_____
	S _____ T _____ R _____	_____
3. Miscellaneous Property In Sec.	S _____ T _____ R _____	_____
	S _____ T _____ R _____	_____

**LI27800PA668**

Compliance with  
ACT 345, P.A. 1990


APPROVED ON: 12-7-94 *DBJ*  
WAYNE COUNTY REMONUMENTATION  
PEER GROUP COMMITTEE

Register of Deeds Stamp & File Number

**RC 1601**

4. Lot No. \_\_\_\_\_, Recorded Plat \_\_\_\_\_  
5. Private Claims \_\_\_\_\_

I, Randy Kolehouse, in a field survey on October 24 19 94, do hereby certify that under requirements of P.A. 74 Michigan P.A. of 1970, the corner points mentioned in lines 1 and 2 above were in conformance with regulations and rules therefore as required in the current manual of survey instructions of the United States Department of the Interior, Bureau of Land Management or by a decree of a Court of Law and/or that the corner points mentioned in lines 3, 4 and 5 above were in conformance with the rules of the Michigan Board of Land Surveyors or by a Decree of a Court of Law; established, re-established, monumented, re-monumented, recovered, found as expressed below:

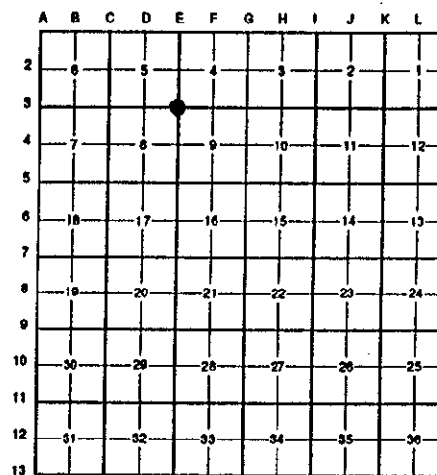

**NOTE: Not more than 4 corners, all in the same town and range, may be recorded on this certificate.**

**A. Description of original monument and accessories and/or subsequent restoration:**

E-3	1817	G.L.O. Notes	N/A	Post
	1930's	WPA Notes	N/A	N/A
	1972	Cert. Survey L.C.R.C. L. 18296 P. 911 #176	Cantrell	Monument in Hand Hole
	1973	WCRC Notes	N/A	Mon. in Box
	1973	L.C.R.C. L. 18715 P. 734 #307	Crossman	Monument in Hand Hole
	1975	Cert. Survey L. 19107 P. 104 #1113	Arthurs	W.C.R.C. Monument
	1976	WCRC Notes	N/A	1/2" Steel Pipe in Conc. Cylinder in Mon. Box
	1976	MDSH	Witnesses	Monument in Mon. Box
	1977	Cert. Survey L. 19884 P. 9.2 #1388	Crossman	Mon. in Box

**B. Description of corner evidence found and/or method applied in restoring or reestablishing corner:**

E-3 I found a 1/2" rebar in a monument box at the center line intersection of Sibley and Telegraph Roads (asphalt). All recorded witnesses were destroyed. This 1/2" rebar checks very close to dist. shown in 1930's WPA surveys.

Measures North to E-2 = 2695.38' (G.L.O. = 2640') (WPA = 2695.03') (MDSH = 2695.40')  
Measures East to F-3 = 2698.40' (G.L.O. = 2641.32') (WPA = 2697.85' & 2698.30') (MDSH = 2698.40')  
Measures West to D-3 = 2637.10' (G.L.O. = 2641.98') (WPA = 2637.68')  
Measures South to E-4 = 2697.51' (G.L.O. = 2640') WPA = 2720.26' & 2710.90') (CS #1113 = 2697.34')

**C. Description of monument for corner and accessories established to perpetuate locating the position of the corner:**

E-3 I placed an aluminum cap stamped "Wayne Co. Remon." on existing 1/2" rebar in an existing monument box.

- P.K. NW Face Lt. Pole N 49° E 68.36'
- C/L Top Nut Hydrant S 57° E 82.92'
- P.K. N Face Util. Pole S 66° W 106.05'
- P.K. SW Face Util. Pole N 56° W 105.65'



The selected location is accepted by the Contractor and is generally accepted by professional surveyors as the best available evidence of the position of the original corner.

Signed by Randy J. Kolehouse Date 12/14/94  
Surveyor's Michigan License No. 25854

2 R  
11-D  
MSC