

FILE DO NOT MAIL

SURVEY & REMONUMENTATION
LAND CORNER RECORDATION CERTIFICATE
Filing Requirement of Act 74, Mich. P.A. 1970

MAR 17 1998


For corners in

<u>WAYNE</u> (County)	Located in: Brownstown Township	Corner Code # E-4
1. Public Land Survey	T <u>4S</u> R <u>10E</u>	<u>E-4</u>
	T _____ R _____	_____
	T _____ R _____	_____
	T _____ R _____	_____
2. Property Controlling in Section	S _____ T _____ R _____	_____
	S _____ T _____ R _____	_____
3. Miscellaneous Property in Sec.	S _____ T _____ R _____	_____
	S _____ T _____ R _____	_____

SECTION
Compliance with
ACT 345, P.A. 1990
APPROVED ON: 12-1-97 *[Signature]*
**WAYNE COUNTY REMONUMENTATION
PEER GROUP COMMITTEE**
Register of Deeds Stamp & File Number

4. Lot No. _____, Recorded Plat _____
5. Private Claims _____

I, Randy Kolehouse, in a field survey on November 5 19 97, do hereby certify that under requirements of P.A. 74 Michigan P.A. of 1970, the corner points mentioned in lines 1 and 2 above were in conformance with regulations and rules therefore as required in the current manual of survey instructions of the United States Department of the interior, Bureau of Land Management or by a decree of a Court of Law and/or that the corner points mentioned in lines 3, 4 and 5 above were in conformance with the rules of the Michigan Board of Land Surveyors or by a Decree of a Court of Law; established, re-established, monumented, re-monumented, recovered, found as expressed below:

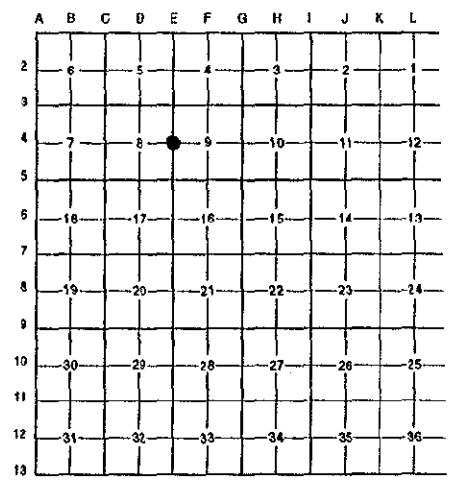

NOTE: Not more than 4 corners, all in the same town and range, may be recorded on this certificate.

A. Description of original monument and accessories and/or subsequent restoration:

E-4	Date	Original Monument	Accessories	Notes	Post
1.	1817	G.L.O.	Fletcher	Notes	Post
2.	1926	Plat	Cautor	L. 60 P. 92	N/A
3.	1930's	WPA Notes	N/A	Section Map and Ties	Iron
4.	1947	Plat	G. Kennedy	N/A	N/A
5.	1972	Cert. Survey	Carlson #14759	L. 18022 P. 45	Iron in Hand Hole
6.	1973	W.C.R.C.	Coon	Witness Records	Monument in Box
7.	1976	MDSH	Swieboda	Witness Card	Monument in Box
8.	1977	Cert. Survey	Ayers #4615	L. 19874 P. 250-252	Monument in Box

B. Description of corner evidence found and/or method applied in restoring or reestablishing corner:

E-4 Found a concrete monument in a monument box 5' North of the C/L intersection of Telegraph Road (asph.) running North and South and Bredow Road (gravel) running East per the following witnesses:

Center sanitary manhole, M= S63E 50.12', R= 50.16' (8): SE corner conc porch, M= N76W 145.69', R= 145.85' (6): "+" top E end conc. Headwall, M= N86W 54.59', R= 54.59' (6 & 7).

\$7.00 DEED
RECORDED
FOREST E. YOUNGBLOOD, REGISTER OF DEEDS
WAYNE COUNTY, MI
Receipt #43169

Measure North to E-3 = 2697.53' (WPA = 2698.28') (G.L.O. = 2640.00') (MDSH = 2697.52)
Measure South to E-5 = 2670.92' (WPA = 2671.08') (G.L.O. = 2640.00') (Kennedy = 2671.01')

C. Description of monument for corner and accessories established to perpetuate locating the position of the corner:

E-4 Set a 2" diameter aluminum cap stamped "Wayne Co. Remon. #25854" on an existing 4" x 36" concrete monument in an existing monument box.

- P.K. Nail in NW Face Util. Pole N 52° E 44.21'
- P.K. Nail in SW Face Util. Pole N 52° E 43.60'
- C/L San. M/H S 63° E 50.12'
- P.K. Nail in SW Face Util. Pole S 43° E 47.58'
- P.K. Nail in N Face Util. Pole S 72° E 102.75'
- Nail w/Shinner in S Face Util. Pole S 80° W 35.78'
- Nail w/W.C.R. Tag in S Face Util. Pole S 80° W 35.80'
- SE Corner Conc. Porch #19956 Telegraph N 76° W 145.69'
- "+" Top East End Conc. Headwall N 86° W 54.59'

The selected location is accepted by the Contractor and is generally accepted by professional surveyors as the best available evidence of the position of the original corner.

Signed by Randy J Kolehouse Date 12/16/97
Surveyor's Michigan License No. 25854

