

SURVEY & REMONUMENTATION

APR 25 1995

RC 1602

\$ 13.00 MISCELLANEOUS RECORDING
28 DEC 94 9:41 A.M. RECEIVED

COMMISSION

LAND CORNER RECORDATION CERTIFICATE
Filing Requirement of Act 74, Mich. P.A. 1970


For corners in

<u>WAYNE</u> (County)	Located in: Brownstown Township	Corner Code #
1. Public Land Survey	T <u>4S</u> R <u>10E</u>	<u>E-5</u>
	T _____ R _____	_____
	T _____ R _____	_____
	T _____ R _____	_____
2. Property Controlling in Section	S _____ T _____ R _____	_____
	S _____ T _____ R _____	_____
3. Miscellaneous Property in Sec.	S _____ T _____ R _____	_____
	S _____ T _____ R _____	_____

L127800PA669
Compliance with ACT 345, P.A. 1990
APPROVED ON: 12-7-94 *DBJ*
WAYNE COUNTY REMONUMENTATION PEER GROUP COMMITTEE
Register of Deeds Stamp & File Number

RC 1602

4. Lot No. _____, Recorded Plat _____
5. Private Claims _____

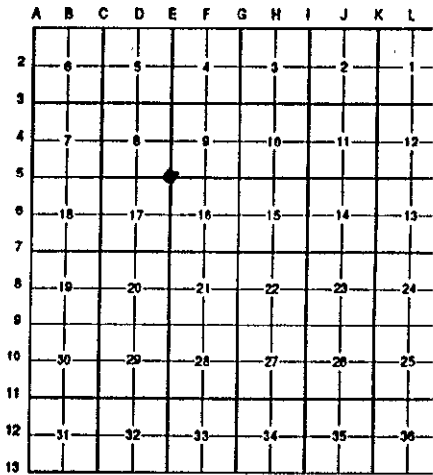

I, Randy Kolehouse, in a field survey on August 3 19 94, do hereby certify that under requirements of P.A. 74 Michigan P.A. of 1970, the corner points mentioned in lines 1 and 2 above were in conformance with regulations and rules therefore as required in the current manual of survey instructions of the United States Department of the Interior, Bureau of Land Management or by a decree of a Court of Law and/or that the corner points mentioned in lines 3, 4 and 5 above were in conformance with the rules of the Michigan Board of Land Surveyors or by a Decree of a Court of Law; established, re-established, monumented, re-monumented, recovered, found as expressed below:

NOTE: Not more than 4 corners, all in the same town and range, may be recorded on this certificate.

A. Description of original monument and accessories and/or subsequent restoration:

E-5	1817	G.L.O. Notes	N/A	Post
	1930's	WPA Notes	N/A	Cross
	1972	Cert. Survey L.C.R.C. L. 18022 P. 45	Carlson	?
	1973	WCRC Notes	N/A	Mon. in Box
	1973	L.C.R.C. L. 18301 P. 286	Wade	N/A
	1974	MDSH & L.C.R.C. L. 18757 P. 204 & 319	Witnesses & Ties	3/8" Rod in 4" Conc. Mon. in Box
	1976	Cert. Survey L. 19338 P. 450 CS #1200	Ayers	Mon. Box
	1977	Cert. Survey L. 19791 P. 732 CS #1322 & 734 CS #1324	Wade	3/8" Rod in Box
	1977	Cert. Survey L. 19894 P. 250 & 252	Ayers	3/8" Rod in Box
	1979	L.C.R.C. Unrecorded Survey L. 20551 P. 453	Sandomierski	Conc. Mon. in Mon. Box
	1987	D.E. Co. Unrecorded Survey	Vanderna	3/8" Rerod in Box
				P.K. Nail & Ribbon in Mon. Box

B. Description of corner evidence found and/or method applied in restoring or reestablishing corner:

E-5 I found concrete monument in existing monument box 8' East of C/L of Telegraph Road (asphalt) running N-S at C/L King Road (gravel) running E-W which agrees with the following witnesses.

Cert. Survey #426	CS #1200	RC # 689	CS #1393
"X" on W Bolt Hyd. S 35° W 88.24'	C/L M/H N 55° W 33.78'	Ref. Nail SE Side Lt. Pole N 30° E 75.55'	C/L Manhole N 55° E 33.78'
P.K. NE Side D.E. Pole S 67° E 103.98'		Ref. Nail N Side Util. Pole S 70° E 103.93'	Nail & Tag in Util. Pole S 70° W 104.00'
	CS #1322 & #1324	C/L Top Bolt F. Hyd. S 35° W 88.14'	
L.C.R.C. #319 (MDSH)	"+" on N/H Rim N 50° E 32.83'	Ref. Nail E Side P. Pole N 20° W 115.10'	D.E. Co.
N 50° E 32.83' "+" on M/H Rim			Nail & Tag in Lt. Pole N 35° E 75.55'
(Meas. 33.85' to C/L M/H Rim Worn)	WCRC Notes		P.K. & Tag in D.E. Pole S 70° E 104.00'
	Nail & Tag E.D. Pole SEly 103.95' (103.97' m)		Fire Hyd. S 45° W 88.1'

Measures West to D-5 = 2641.22' (G.L.O. = 2663.40') (WPA = 2641.47') (D.E. Co. = 2641.59')
Measures North to E-4 = 2670.89' (G.L.O. = 2640') (WPA = 2671.01' S-8 - 2671.01' S-8) (D.E. Co. = 2641.59') (CS #1393 - 2670.92')
Measures South to E-6 = 2639.46' (G.L.O. = 2640') (WPA = 2640.45') (MDSH = 2639.51')

C. Description of monument for corner and accessories established to perpetuate locating the position of the corner:

E-5 I set an aluminum cap stamped "Wayne Co. Remon." on existing concrete monument in an existing monument box
Nail w/Tag "MDSH" SE Face Util. Pole N 29° E 75.42'
Nail w/Tag "WCRC" NE Face Util. Pole S 63° E 103.97'
C/L Top Nut Hyd. S 40° W 88.11'
Ref. Nail E. Face Util. Pole N 16° W 114.95'

The selected location is accepted by the Contractor and is generally accepted by professional surveyors as the best available evidence of the position of the original corner.

Signed by Randy J. Kolehouse Date 12/14/94
Surveyor's Michigan License No. 25854

