

FILE DO NOT MAIL

LAND CORNER RECORDATION CERTIFICATE
Filing Requirement of Act 74, Mich. P.A. 1970

SURVEY & REMONUMENTATION

MAR 17 1998


SECTION

Compliance with
ACT 345, P.A. 1990

APPROVED ON: 12-1-97 *DK*
WAYNE COUNTY REMONUMENTATION
PEER GROUP COMMITTEE
Register of Deeds Stamp & File Number

For corners in

WAYNE (County)	Located in: Brownstown Township	Corner Code #
1. Public Land Survey	T <u>4S</u> R <u>10E</u>	<u>E-6</u>
	T _____ R _____	_____
	T _____ R _____	_____
	T _____ R _____	_____
2. Property Controlling in Section	S _____ T _____ R _____	_____
	S _____ T _____ R _____	_____
3. Miscellaneous Property in Sec.	S _____ T _____ R _____	_____
	S _____ T _____ R _____	_____
4. Lot No. _____, Recorded Plat _____		
5. Private Claims _____		

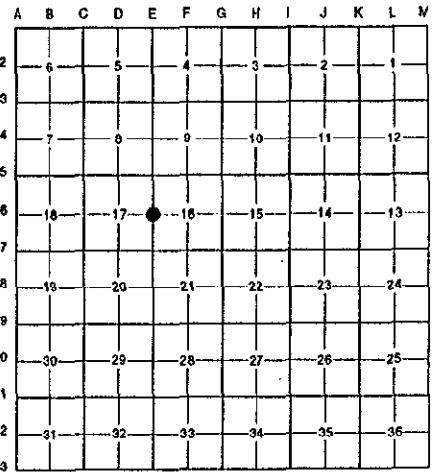

I, Randy Kolehouse, in a field survey on November 6 19 97, do hereby certify that under requirements of P.A. 74 Michigan P.A. of 1970, the corner points mentioned in lines 1 and 2 above were in conformance with regulations and rules therefore as required in the current manual of survey instructions of the United States Department of the interior, Bureau of Land Management or by a decree of a Court of Law and/or that the corner points mentioned in lines 3, 4 and 5 above were in conformance with the rules of the Michigan Board of Land Surveyors or by a Decree of a Court of Law; established, re-established, monumented, re-monumented, recovered, found as expressed below:

NOTE: Not more than 4 corners, all in the same town and range, may be recorded on this certificate.

A. Description of original monument and accessories and/or subsequent restoration:

E-6	1. 1817	G.L.O.	Fletcher	Notes	Post
	2. 1924	Plat	N/A	L. 48 P. 46	N/A
	3. 1924	Plat	N/A	L. 50 P. 72	N/A
	4. 1930's	WPA Notes	N/A	Section Map and Ties	Cross
	5. 1971	Cert. Survey	Carlson #14759	L. 18022 P. 48-49	Iron
	6. 1972	Cert. Survey	Wade #11868	L. 18301 P. 286	Iron Pipe
	7. 1974	L.C.R.C.	N. Jones	L. 18757 P. 206	Set Ackerman & Bolt
	8. 1974	MSHD	Petrie	Witness Card	Ackerman Plug
	9. 1975	Cert. Survey	Arthurs #11358	L. 19078 P. 673	N/A
	10. 1976	Cert. Survey	Stanley #12031	L. 19855 P. 739	N/A
	11. 1977	Cert. Survey	Wade #11868	L. 19791 P. 734	Ackerman & Bolt in Conc. Pvmt.
	12. 1979	L.C.R.C.	Sandomerski #24616	L. 20551 P. 452	Conc. Pvmt/P.K. Nail in Road

\$4.00 REMONUMENTATION

B. Description of corner evidence found and/or method applied in restoring or reestablishing corner:

E-6 Found a P.K. Nail at the C/L intersection of Telegraph Road (asph) running North and South and Carter Road (asph.) running East per the following witnesses:

\$7.00 DEED

Nail w/MDSH tag NW side util pole, M= N43E 56.56,
R= 56.31' (7 & 11), 56.55' (12): PK SE face util pole, M= N43E 56.33', R= 56.24' (6): "+" NW corner rim of CB, M= S35E 60.00', R= 60.09' (7 & 11), 60.14' (12): PK W side util pole, M= N84W 38.97', R= 38.89' (6), 39.04' (7 & 11): Nail/bottle cap S side util pole, M= N84W 38.94', M= 38.95" (12).
Measure North to E-5 = 2639.46' (WPA = 2640.45') (G.L.O. = 2640.00') (MDSH = 2639.51')
Measure South to E-7 = 2635.33' (WPA = 2634.37') (G.L.O. = 2640.00')

Receipt #43169

RECORDED
FOREST E. YOUNGBLOOD, REGISTER OF DEEDS
WAYNE COUNTY, MI

C. Description of monument for corner and accessories established to perpetuate locating the position of the corner:

E-6 Replaced an existing P.K. nail with a 1/2" x 36" rebar and a 2" aluminum cap stamped "Wayne Co. Remon. #25854." Also set a new monument box.

Nail w/MDSH Tag in NW Side Util. Pole N 43° E 56.56' Nail w/MDSH Tag in S Side Util. Pole N 84° W 38.97'
P.K. Nail in SE Face Util. Pole N 43° E 56.33' Nail in Bottle Cap in S Side Util. Pole N 84° W 38.94'
"+" NW Corner Rim C.B. S 35° E 60.00'

The selected location is accepted by the Contractor and is generally accepted by professional surveyors as the best available evidence of the position of the original corner.

Signed by Randy J. Kolehouse Date 12/16/97
Surveyor's Michigan License No. 25854

