

SURVEY & REMONUMENTATION

APR 25 1995

RC 1603

COMMISSION

LAND CORNER RECORDATION CERTIFICATE
Filing Requirement of Act 74, Mich. P.A. 1970

\$ 13.00 MISCELLANEOUS RECORDING
28 DEC 94 9:41 A.M. RECEIPT# 169
RECORDED
FOREST E. YORPALAND, REGISTER OF DEEDS
WAYNE COUNTY MI

For corners in

<u>WAYNE</u> (County)	Located in:	City of Flat Rock	Corner Code #
1. Public Land Survey	T <u>4S</u>	R <u>10E</u>	<u>E-11</u>
	T _____	R _____	_____
	T _____	R _____	_____
	T _____	R _____	_____
2. Property Controlling in Section	S _____	T _____	R _____
	S _____	T _____	R _____
3. Miscellaneous Property in Sec.	S _____	T _____	R _____
	S _____	T _____	R _____

L127800PAS70

Compliance with
ACT 345, P.A. 1990

APPROVED ON: 12-7-94 *JR*
WAYNE COUNTY REMONUMENTATION
PEER GROUP COMMITTEE


Register of Deeds Stamp & File Number

RC 1603

4. Lot No. _____, Recorded Plat _____
5. Private Claims _____

I, Randy Kolehouse, in a field survey on August 2 19 94, do hereby certify that under requirements of P.A. 74 Michigan P.A. of 1970, the corner points mentioned in lines 1 and 2 above were in conformance with regulations and rules therefore as required in the current manual of survey instructions of the United States Department of the Interior, Bureau of Land Management or by a decree of a Court of Law and/or that the corner points mentioned in lines 3, 4 and 5 above were in conformance with the rules of the Michigan Board of Land Surveyors or by a Decree of a Court of Law; established, re-established, monumented, re-monumented, recovered, found as expressed below:

NOTE: Not more than 4 corners, all in the same town and range, may be recorded on this certificate.

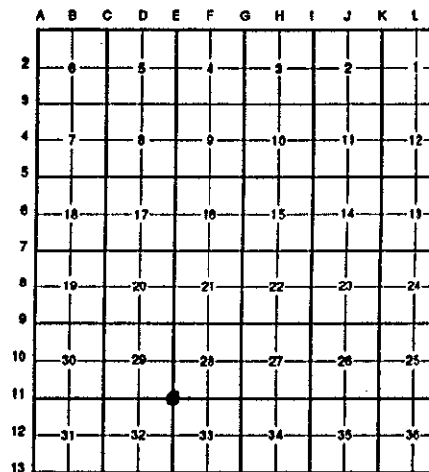

A. Description of original monument and accessories and/or subsequent restoration:

E-11	1817	G.L.O. Notes	N/A	Post
	1922	D.E. Co. Field Notes	N/A	Hard Head Stone w/Copper Bolt
	1930's	WPA Notes	N/A	Iron
	1971	L.C.R.C. and Cert. Surveys L. 18022 P. 31, 33 & 38 CS 114 and CS 119	Carlson	Iron Bar in Monument Box
	1973	WCRC Notes	N/A	Iron in Mon. Box
	1991	D.E. Co. Unrecorded Cert. Survey & Field Notes	Stephens	

B. Description of corner evidence found and/or method applied in restoring or reestablishing corner:

E-11 I found 1/2" rebar in monument box at C/L of Vreeland Rd. (conc.) and Cahill Rd. (gravel) which agrees with the following witnesses.

L.C.R.C. L. 18022 P. 31	WCRC
S 59° E 87.10' to Top of Hydrant (87.28' m)	Nail & Tag D.E. Pole NE'ly 156.71' (156.82' m)
	Nail & Tag Bell Pole SE'ly 93.18' (93.17' m)
	Nail & Tag Bell Pole SW'ly 65.96' (65.80' m)
	Nail & Tag D.E. Pole NW'ly 59.35' (59.38' m)

D.E. Company
N 10° E 62.25' C/L Gate Post 6' C/L Fence (62.20' m)
S 50° E 93.15' Nail w/Tag "WCRC" SW Face M.B.T. Pole (93.19' m)
S 40° W 65.83' Nail w/Tag "WCRC" SE Face M.B.T. Pole (65.80' m)
N 20° W 59.40' Nail w/Tag "WCRC" E Side D.E. Pole (59.38' m)
N 75° E 156.70' Nail w/Tag "WCRC" SE Side D.E. Pole (156.82' m)

Measures South to E-13 = 5237.65' (G.L.O. = 5280') (WPA = 5236.76') (CS #119 = 5237.55')
Measures East to F-11 = 2671.46' (G.L.O. = 2635.38') (WPA = 2671.83' S-28 - 2671.40' S-33)
Measures West to D-11 = 2596.08' (G.L.O. = 2636.37') (WPA = 2597.45' S-29 - 2597.49' S-32)


C. Description of monument for corner and accessories established to perpetuate locating the position of the corner:

E-11 I set an aluminum cap stamped "Wayne Co. Remon." on existing 1/2" rebar in an existing monument box.

Nail w/Tag "WCRC" S Face Util. Pole N 76° E 156.82'
Nail w/Tag "WCRC" SW Face Util. Pole S 50° E 93.17'
Nail w/Tag "WCRC" SE Face Util. Pole S 45° W 65.80'
Nail w/Tag "WCRC" NE Face Util. Pole N 23° W 59.38'

The selected location is accepted by the Contractor and is generally accepted by professional surveyors as the best available evidence of the position of the original corner.

Signed by Randy J. Kolehouse Date 12/14/94
Surveyor's Michigan License No. 25854

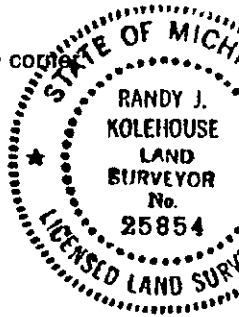

2 R
11 L
MIS