

FILE DO NOT MAIL

LAND CORNER RECORDATION CERTIFICATE  
Filing Requirement of Act 74, Mich. P.A. 1970

For corners in

<u>Wayne</u> (County)	Located In: City of Flat Rock	Corner Code # F-13
1. Public Land Survey	T 4 S R 10 E	
	T R	
	T R	
	T R	
2. Property Controlling in Section	S T R	
	S T R	
3. Miscellaneous Property in Sec.	S T R	
	S T R	

Liber-30864 Page-15  
99595628 12/30/1999  
F.E. Youngblood, Wayne Co. Register of Deeds

Compliance with  
ACT 345, P.A. 1990  
APPROVED ON: 12-8-99  
WAYNE COUNTY REMONUMENTATION  
PEER GROUP COMMITTEE

Register of Deeds Stamp & File Number

4. Lot No. \_\_\_\_\_, Recorded Plat \_\_\_\_\_  
5. Private Claims \_\_\_\_\_

A	B	C	D	E	F	G	H	I	J	K	L	M
1												
2	6		5		4		3		2		1	
3												
4	7		8		9		10		11		12	
5												
6	18		17		16		15		14		13	
7												
8	19		20		21		22		23		24	
9												
10	30		29		28		27		26		25	
11												
12	31		32		33		34		35		36	
13												

I, Michael S. Hoben, in a field survey on Sept. 16, 1999 do hereby state that under requirements of P.A. 74, Michigan P.A. of 1970, the corner points mentioned in lines 1 and 2 above were in conformance with regulations and rules therefore as required in the current manual of survey instructions of the United States Department of the Interior, Bureau of Land Management or by a decree of a Court of Law and /or that the corner points mentioned in lines 3, 4 and 5 above were in conformance with the rules of the Michigan Board of Land Surveyors or by a Decree of a Court of Law; established, re-established, monumented, recovered, found as expressed below:

NOTE: Not more than 2 corners, all in the same town and range, may be recorded on this certificate.

A. Description of original monument and accessories and/or subsequent restoration:

F-13 1817 GLO Notes	Preston		
N/A	Post		
1930's WPA witnesses			
1930's Section dimensions			
1941 Chapman Farms No.1	Eisenach	1341	Set iron NA
1973 WCRC			
1995 LCRC	Kolehouse	25854	

B. Description of corner evidence found and/or method applied in restoring or reestablishing corner:

F-13 I found a 1/2" rebar in a monument box 3' +/- S. of the centerline of Gibraltar RD. (conc.) at the centerline of a high voltage power line running N/S. No previous witnesses remain.

Distance to E-13 = 2645.04' (GLO = 2640')(WPA = 2846.12')  
Distance to G-13 = 2648.59' (GLO = 2640')(WPA = 2647.56')  
Distance to F-1 T5SR10E = 245.74' (WPA = 245.62')

WPA witnesses 1930  
NW 89.60' "V" cut in W side of DE tower (gone)  
NE 87.88' "V" cut in E side of DE tower (gone)  
SW 42.33' to P.K. nail in MBT pole (gone)  
W 245.62' to F-1  
NW 43.87' to P.K. nail in DE pole (gone)

RF


FEB 28 2000

SECTION

C. Description of monument for corner and accessories established to perpetuate locating the position of the corner:

F-13 I set a 2" aluminum cap stamped "Wayne County Monument MI Act 345 #35994" on the existing rebar in the existing mon. box. Not a common corner.

N 35° E	48.58'	Set "+" on SW'ly bolt on a light pole base
N 30° E	125.84'	Nail w/WCReмон tag NW'ly face Util. Pole
S 70° E	141.69'	Set "+" on SW'ly bolt on a light pole base
S 74° W	109.54'	Set "+" on NE'ly bolt on a light pole base (
N 50° W	92.66'	Nail w/WCReмон tag NW'ly face Util. Pole

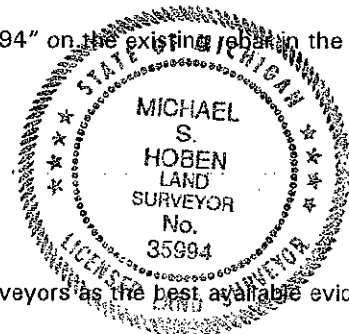

The selected location is accepted by me and is generally accepted by Professional Surveyors as the best available evidence of the position of the original corner.

Signed by Michael S. Hoben

Date Dec 27, 1999

Surveyor's Michigan License No. 35994

FORM APPROVED BY MICHIGAN STATE BOARD OF LAND SURVEYORS, JAN. 28, 1971

REVISED MAY 14, 1975  
REVISED JAN., 1983  
REVISED OCT., 1999

R LCR 9 4R 1 Pg A