

APR 05 1996

COMMISSION LAND CORNER RECORDATION CERTIFICATE
 Filing Requirement of Act 74, Mich. P.A. 1970

For corners in

<u>WAYNE</u> (County)	Located in: <u>Brownstown</u> Township	Corner Code # <u>G-2</u>
1. Public Land Survey	T <u>4S</u> R <u>10E</u>	<u>G-2</u>
	T _____ R _____	_____
	T _____ R _____	_____
	T _____ R _____	_____
2. Property Controlling in Section	S _____ T _____ R _____	_____
	S _____ T _____ R _____	_____
3. Miscellaneous Property in Sec.	S _____ T _____ R _____	_____
	S _____ T _____ R _____	_____

LIBER 28451 PAGE 498

Compliance with
 ACT 345, P.A. 1990


APPROVED ON: 11-28-95 *D.P.J.*
WAYNE COUNTY REMONUMENTATION
PEER GROUP COMMITTEE

Register of Deeds Stamp & File Number

4. Lot No. _____, Recorded Plat _____
 5. Private Claims _____

I, Randy Kolehouse, in a field survey on November 28 19 94, do hereby certify that under requirements of P.A. 74 Michigan P.A. of 1970, the corner points mentioned in lines 1 and 2 above were in conformance with regulations and rules therefore as required in the current manual of survey instructions of the United States Department of the Interior, Bureau of Land Management or by a decree of a Court of Law and/or that the corner points mentioned in lines 3, 4 and 5 above were in conformance with the rules of the Michigan Board of Land Surveyors or by a Decree of a Court of Law; established, re-established, monumented, re-monumented, recovered, found as expressed below:

NOTE: Not more than 4 corners, all in the same town and range, may be recorded on this certificate.

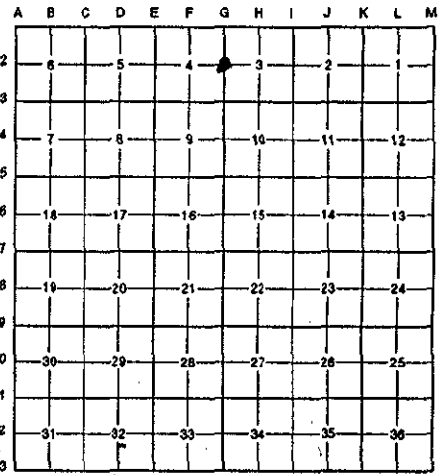

A. Description of original monument and accessories and/or subsequent restoration:

G-2	1817	G.L.O. Notes	N/A	Post
	1930's	WPA Notes	N/A	Iron
	1973	WCRC Notes	N/A	3/4" Iron
	1973	L.C.R.C. L. 18673 P. 341 RC 29A	Jones	1/2" Pipe
	1973	MDSH Field Notes	N/A	1/2" Pipe
	1975	Plat "Southland Village Estates Sub. No. 3 L. 96 P. 20	N/A	N/A

95262453

B. Description of corner evidence found and/or method applied in restoring or reestablishing corner:

G-2 Found 1/2" pipe in monument box 1' East C/L of Racho Road (asphalt). This point does agree with WCRC ties but does not agree with MDOT witnesses, WPA measured angle or distances, and the plat of "Southland Village Estates Subdivision No. 3." Set P.K. to agree with MDOT witnesses which will agree with WPA and be closer to plat dimension. Falls 4' West C/L of Racho Road. P.K. agrees with the following.

MDOT Field Notes & L.C.R.C. L. 18673 P. 341 RC 298	WPA Notes
P. Pole S 85° W 52.24' (52.22' m)	Record Angle from SE Cor. Sec. 4 to NE Cor. Sec. 4 = 179°51'30"
P. Pole East 50.75' (50.70' m)	Record Angle from SW Cor. Sec. 3 to NW Cor. Sec. 3 = 179°51'20"
1/2" Pipe N 79° E 5.13' (5.09' m)	Angle Measured in Field at P.K. = 179°51'02"
	Angle Measured in Field at 1/2" Pipe = 179°38'20"

Measures North to G-1 = 2775.64' from Pipe - 2776.78' from P.K. (G.L.O. = 2772.00') (WPA = 2776.41')
 Measures South to G-3 = 2637.08' from Pipe - 2635.90' from P.K. (G.L.O. = 2640') (WPA = 2635.95') (MDSH = 2635.90')
 Measures West to Plat Cor. = 65.00' ± from Pipe - 59.90' ± from P.K. (60.19' r)

C. Description of monument for corner and accessories established to perpetuate locating the position of the corner:

- G-2 Replaced P.K. with 1/2" rebar and aluminum cap "Wayne Co. Remon." *IN A NEW MONUMENT BOX*
- Nail w/Tag "WCRC" NW Face 15" Elm N 45° E 57.07'
 - Nail w/Tag "WCRC" N Face Util. Pole S 88° E 50.70'
 - Nail w/Tag "WCRC" SW Face Util. Pole S 62° E 46.70'
 - Nail w/Tag "WCRC" NW Face Util. Pole S 47° W 73.89'
 - Nail w/Tag "WCRC" N Face Util. Pole West 52.22'
 - 1/2" Pipe in Monument Box N 85° E 5.09'



The selected location is accepted by the Contractor and is generally accepted by professional surveyors as the best available evidence of the position of the original corner.

Signed by Randy J. Kolehouse Date 12/2/95
 Surveyor's Michigan License No. 25854