

DEC 02 1993

RC 1105

COMMISSION

LAND CORNER RECORDATION CERTIFICATE

Filing Requirement of Act 74, Mich. P.A. 1970

LI 26951 PA 726

For corners in

Wayne (County)	Located In:	Corner Code #
1. Public Land Survey	T 4S R 10E	G-5
	T R	
	T R	
	T R	
2. Property Controlling in Section	S T R	
	S T R	
3. Miscellaneous Property in Sec.	S T R	
	S T R	
4. Lot No. _____, Recorded Plat _____		
5. Private Claims _____		

Compliance with  
ACT 345, P.A. 1990

APPROVED ON: 10-28-93 *[Signature]*  
WAYNE COUNTY REMONUMENTATION  
PEER GROUP COMMITTEE

RC 1105

Register of Deeds Stamp & File Number

	A	B	C	D	E	F	G	H	I	J	K	L	M
2	6	5	4	3	2								
3													
4	7	8	9	10	11	12							
5													
6	18	17	16	15	14	13							
7													
8	19	20	21	22	23	24							
9													
10	30	29	28	27	26	25							
11													
12	31	32	33	34	35	36							
13													

I, Bruce Antcliff, in a field survey on August 26, 19 93, do hereby certify that under requirements of P.A. 74, Michigan P.A. of 1970, the corner points mentioned in lines 1 and 2 above were in conformance with regulations and rules therefore as required in the current manual of survey instructions of the United States Department of the Interior, Bureau of Land Management or by a decree of a Court of Law and/or that the corner points mentioned in lines 3, 4 and 5 above were in conformance with the rules of the Michigan Board of Land Surveyors or by a Decree of a Court of Law; established, re-established, monumented, re-monumented, recovered, found as expressed below.

**NOTE: Not more than 4 corners, all in the same town and range, may be recorded on this certificate.**

A. Description of original monument and accessories and/or subsequent restoration:

GLO-Post  
WPA (1930'S) - Iron  
LCRC (1972) - 1" Iron Pipe (L 18177, P 896)

B. Description of corner evidence found and/or method applied in restoring or reestablishing corner:

Iron Pipe; Measured to S1/4 S.9 & S1/4 S.10 -  
Distances checked well with WPA Surveys.

C. Description of monument for corner and accessories established to perpetuate locating the position of the corner:

Set 4" x 36" Conc. Monument with Wayne County Remonumentation Marker and Cap #25826.

Witnesses


WCRC Nail & Tag E. side P.P., N, 31.20'  
Top Cen. Fire Hyd., NE, 65.70'  
Top Cen. Fire Hyd., SE, 35.20'  
WCRC Nail & Tag E. side P.P., SSE, 47.72'

The selected location is accepted by the Contractor and is generally accepted by professional surveyors as the best available evidence of the position of the original corner.

Signed by Bruce Antcliff

Date 11-10-93

Surveyor's Michigan License No. 25826

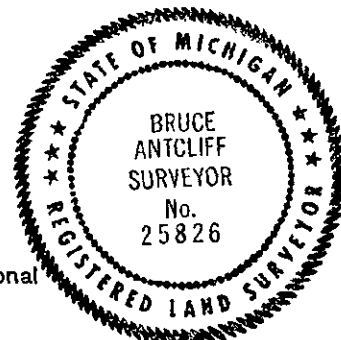

20 NOV 10 PM 2:19  
FORGOTTEN RECORDS  
MICHIGAN STATE BOARD OF LAND SURVEYORS