

DEC 02 1993

RC 1106

COMMISSION

LAND CORNER RECORDATION CERTIFICATE  
Filing Requirement of Act 74, Mich. P.A. 1970

For corners in

Wayne (County)	Located In:	Corner Code #
1. Public Land Survey	T- <u>4S</u> R <u>10E</u>	<u>G-7</u>
	T _____ R _____	_____
	T _____ R _____	_____
	T _____ R _____	_____
2. Property Controlling in Section	S _____ T _____ R _____	_____
	S _____ T _____ R _____	_____
3. Miscellaneous Property in Sec.	S _____ T _____ R _____	_____
	S _____ T _____ R _____	_____

LI 26951 PA 727

Compliance with  
ACT 345, P.A. 1990

APPROVED ON: 10-28-93  
WAYNE COUNTY REMONUMENTATION  
PEER GROUP COMMITTEE

Register of Deeds Stamp & File Number

- 4. Lot No. \_\_\_\_\_, Recorded Plat \_\_\_\_\_
- 5. Private Claims \_\_\_\_\_

I, Bruce Antcliff, in a field survey on August 20, 19 93,  
do hereby certify that under requirements of P.A. 74, Michigan P.A. of 1970, the corner points mentioned  
in lines 1 and 2 above were in conformance with regulations and rules therefore as required in the  
current manual of survey instructions of the United States Department of the Interior, Bureau of Land  
Management or by a decree of a Court of Law and/or that the corner points mentioned in lines 3, 4 and 5  
above were in conformance with the rules of the Michigan Board of Land Surveyors or by a Decree of a  
Court of Law; established, re-established, monumented, re-monumented, recovered, found as  
expressed below.

NOTE: Not more than 4 corners, all in the same town and range, may be recorded on this certificate.

	A	B	C	D	E	F	G	H	I	J	K	L	M
2	6	5	4	3	2	1							
3													
4	7	8	9	10	11	12							
5													
6	18	17	16	15	14	13							
7													
8	19	20	21	22	23	24							
9													
10	30	29	28	27	26	25							
11													
12	31	32	33	34	35	36							
13													

A. Description of original monument and accessories and/or subsequent restoration:

- GLO-Post
- WPA (1930'S) - Iron
- MDOT (1981) - 3/4" Rod in Mon. Box
- LCRC (1975) - Conc. Mon. in Mon. Box (L 19232, P 322)
- Rec. Survey (1978) - Mon. in Mon. Box (L 20184, P 870)

B. Description of corner evidence found and/or method applied in restoring or reestablishing corner:

- Conc. Mon., Measured to S1/4 S.16 & SW S.16
- Distances checked well with WPA Surveys.

C. Description of monument for corner and accessories established to perpetuate locating the position of the corner:

Set Wayne County Remonumentation Marker and Cap #25826 on existing monument.


Witnesses

- WCRC Nail & Tag SE'ly side tel. pole, NE, 73.70'
- WCRC Nail & Tag NE'ly side P.P., SE, 69.89'
- WCRC Nail & Tag SE'ly side P.P., SSW, 74.91'
- \*+ NE Cor. Base "Amoco" sign, SW, 90.32'
- MDOT Nail & Tag SW'ly side P.P., NW, 66.57'
- \*+ SE side of Conc. Cover for Wet Well, NNW, 83.01'

The selected location is accepted by the Contractor and is generally accepted by professional surveyors as the best available evidence of the position of the original corner.

Signed by Bruce Antcliff  
Surveyor's Michigan License No. 25826

Date 11-10-93

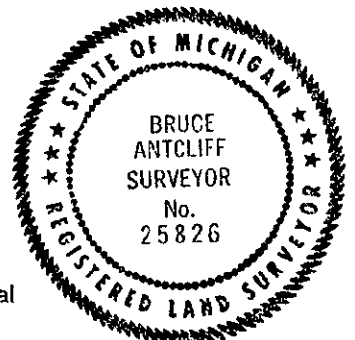

93 NOV 10 PM 2:19  
 BOARD OF SURVEYORS  
 MICHIGAN