

**SURVEY &
REMONUMENTATION**

RC 1605

\$ 13.00 MISCELLANEOUS RECORDING
28 DEC 94 9:41 A.M. RECEIPT# 149
RECORDED

APR 25 1995

LAND CORNER RECORDATION CERTIFICATE
Filing Requirement of Act 74, Mich. P.A. 1970

WEST E. YORKSHIRE, REGISTER OF DEEDS
L1278006 PA672


For corners in **COMMISSION**

| Wayne (County) | Located In: | City of Flat Rock | Corner Code # |
|---------------------------------------|-------------|----------------------|---------------|
| 1. Public Land Survey | T <u>4S</u> | R <u>10E</u> | <u>G-13</u> |
| | T _____ | R _____ | _____ |
| | T _____ | R _____ | _____ |
| | T _____ | R _____ | _____ |
| 2. Property Controlling in Section | S _____ | T _____ | R _____ |
| | S _____ | T _____ | R _____ |
| 3. Miscellaneous Property in Sec. | S _____ | T _____ | R _____ |
| | S _____ | T _____ | R _____ |

Compliance with
ACT 345, P.A. 1990
APPROVED ON: 12-7-94 *DBJ*
WAYNE COUNTY REMONUMENTATION
PEER GROUP COMMITTEE
Register of Deeds Stamp & File Number

4. Lot No. _____, Recorded Plat _____
5. Private Claims _____

I, Randy Kolehouse, in a field survey on September 6 19 94, do hereby certify that under requirements of P.A. 74 Michigan P.A. of 1970, the corner points mentioned in lines 1 and 2 above were in conformance with regulations and rules therefore as required in the current manual of survey instructions of the United States Department of the interior, Bureau of Land Management or by a decree of a Court of Law and/or that the corner points mentioned in lines 3, 4 and 5 above were in conformance with the rules of the Michigan Board of Land Surveyors or by a Decree of a Court of Law; established, re-established, monumented, re-monumented, recovered, found as expressed below:

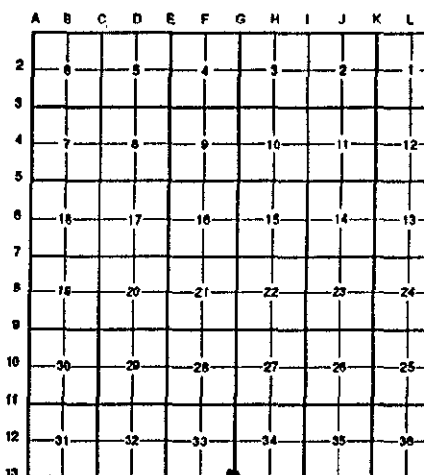

NOTE: Not more than 4 corners, all in the same town and range, may be recorded on this certificate.

A. Description of original monument and accessories and/or subsequent restoration:

| Date | Description | Notes | Material |
|-----------|----------------------------------|--------------|-----------------------------|
| G-13 1817 | G.L.O. Notes | N/A | Post |
| 1930's | WPA Notes | N/A | |
| 1963 | D.E. Co. Field Notes | N/A | 3/4" Iron |
| 1984 | D.E. Co. Field Notes | N/A | 1/2" Iron Pipe in Mon. Box. |
| 1986 | L.C.R.C. L. 23013 P. 678 RC #881 | Sandomierski | 1/2" Re-Rod in Monument Box |

B. Description of corner evidence found and/or method applied in restoring or reestablishing corner:

G-13 Found 1/2" rebar in monument box at C/L of Gibraltar Road (asphalt) running E & W which checks the following witnesses and WPA measurements.

| D.E. Company 1984 | L.C.R.C. #881 |
|-------------------------------------|---|
| Nail & Disc. P. Pole N 40° E 71.75' | N 40°56' E 71.70' Ref. Nail SE Side D.E. Pole |
| Nail & Disc. P. Pole S 40° E 69.51' | S 43°13' E 69.54' Ref. Nail NE Side LI. Pole |

Measures West to G-13 T4S R10E = 2648.60' (G.L.O. = 2640') (WPA = 2647.58')
Masures West to G-1 T5S R10E = 247.46' (G.L.O. = 250.80') (WPA = 246' ±)

C. Description of monument for corner and accessories established to perpetuate locating the position of the corner:

G-13 Set an aluminum cap stamped "Wayne Co. Remon." on existing 1/2" rebar in an existing monument box.

- Nail w/Ref. Tag SE Face Util. Pole N 44° E 71.72'
- Nail w/Ref. Tag NE Face Util. Pole S 40° E 69.47'
- P.K. in Top of Curb S 26° W 48.62'
- SE Side E Most Post 4" Dia. Steel Filled w/Conc. N 22° W 69.21'



The selected location is accepted by the Contractor and is generally accepted by professional surveyors as the best available evidence of the position of the original corner.

Signed by Randy J. Kolehouse Date 12/14/94
Surveyor's Michigan License No. 25854