

FILE DO NOT MAIL

LAND CORNER RECORDATION CERTIFICATE
Filing Requirement of Act 74, Mich. P.A. 1970

For corners in

Wayne (County) Located In: City of Flat Rock Corner Code # H-11
1. Public Land Survey T 4 S R 10 E
2. Property Controlling in Section S T R
3. Miscellaneous Property in Sec. S T R


Liber-30864 Page-19
99595871 12/30/1999
F.E. Youngblood, Wayne Co. Register of Deeds
RDANDSYL

Compliance with ACT 345, P.A. 1990
APPROVED ON: 12-8-99
WAYNE COUNTY REMONUMENTATION PEER GROUP COMMITTEE
Register of Deeds Stamp & File Number

4. Lot No. , Recorded Plat

5. Private Claims

I, Michael S. Hoben in a field survey on Sept. 23, 1999 do hereby state that under requirements of P.A. 74, Michigan P.A. of 1970, the corner points mentioned in lines 1 and 2 above were in conformance with regulations and rules therefore as required in the current manual of survey instructions of the United States Department of the Interior, Bureau of Land Management or by a decree of a Court of Law and/or that the corner points mentioned in lines 3, 4 and 5 above were in conformance with the rules of the Michigan Board of Land Surveyors or by a Decree of a Court of Law; established, re-established, monumented, recovered, found as expressed below:

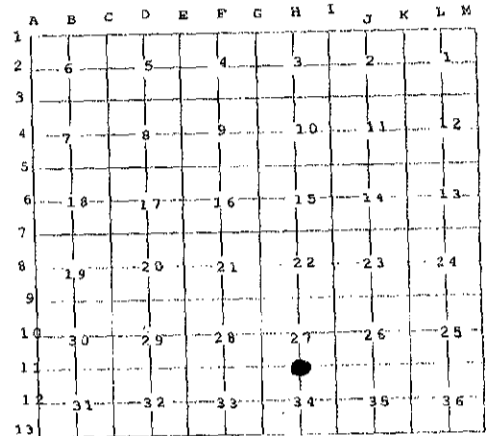

NOTE: Not more than 2 corners, all in the same town and range, may be recorded on this certificate.

A. Description of original monument and accessories and/or subsequent restoration:


B. Description of corner evidence found and/or method applied in restoring or reestablishing corner:

H-11 I found three PK's 4.7' +/- S. of the South edge the travel lanes of Vreeland RD. (Asph.) in a widening for a turn lane. The PK's are 0.50' +/- apart. Using the center PK, one is NW'ly 0.19' and one is NE'ly 0.28'. This point agrees with the following witnesses:


- NE "+" rim M/H 20.85'M (WCRC=20.84')(LCRC'76 and '79=20.83')
SW NE corner house #21005 102.00'M (LCRC'79=102.33')
SW PK in Util. Pole 43.73'M (LCRC'76 and '79=44.00')
West Conc. mon. in box 309.06'M (LCRC'79=308.69')

Distance to G-11 = 2815.98' (GLO = 2712.6')(WPA = 2815.49')
Distance to I-11 = 2923.27' (GLO = 2712.6')(WPA = 2923.00')
Measured angle is 192°18'23"; Record angle WPA is 192°18'40" for Section 34 and 192°18'20" for Section 27.

B. Description of monument for corner and accessories established to perpetuate locating the position of the corner:

B-13 I replaced the three PK's with 1/2" x 18" rebar with a 2" aluminum cap stamped "Wayne County Monument MI Act 345 #35994" in a new monument box in the asphalt pavement.


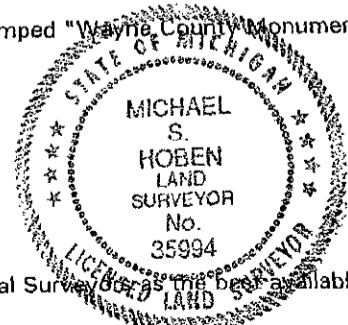

The selected location is accepted by me and is generally accepted by Professional Surveyors as the best available evidence of the position of the original corner.

Signed by Michael S. Hoben
Surveyor's Michigan License No. 35994

Date Dec. 27, 1999

FORM APPROVED BY MICHIGAN STATE BOARD OF LAND SURVEYORS, JAN. 28, 1971

REVISED MAY 14, 1976
REVISED JAN., 1983
REVISED OCT., 1999

R LCR 12 4 R 2 Pgs A DJJ

LCRC L.19472, P. 774

A steel rod located 4.83 feet from the S. edge of conc. Pave.

NE 44.0 nail in SE side utility pole. (gone)

NE 100.92 feet from the NE corner of house. (gone)

S 20.83 feet from "X" in rim of sanitary man hole. (M 20.85')

Liber-30864

Page-20

LCRC L.18381, P. 465

Found Iron:

N. 63.00 feet, P.K. nail in tree stump. (gone).

N. 23.62 feet, notch in rim of san. Sewer Man hole.

NE 30.00 P.K., nail in center line of Vreeland Rd. (gone).

S. 43.64 feet, Monument defined by Wayne County Road Commission. (did not find.)

NW 19.99 feet, P.K. nail in centerline of Pave. (Vreeland Rd.). (gone)

LCRC L.20551, P. 927

Found Iron Rod:

SE 97.38 feet from SE corner of conc. Blk. Building (gone)

S 20.83 feet from a cross in rim of san man hole.

W 308.69 feet from W.C.R.C. hand hole monument on S. section line (P.O.C. of pavement).

NE 44.0 feet from nail in SE side of utility pole.

NE 102.33 feet from NE corner of conc. Block footing of house.

RE

FEB 28 2000

SECTION