

SURVEY & REMONUMENTATION

FEB 28 1994

RC 1369

COMMISSION

LAND CORNER RECORDATION CERTIFICATE
Filing Requirement of Act 74, Mich. P.A. 1970

For corners in

Table with columns: WAYNE (County), Located In:, Corner Code #. Rows include Public Land Survey, Property Controlling in Section, Miscellaneous Property in Sec.

LI 27059 PA 143

Compliance with ACT 345, P.A. 1990

APPROVED ON: 12-21-93 [Signature]
WAYNE COUNTY REMONUMENTATION PEER GROUP COMMITTEE

Register of Deeds Stamp & File Number

4. Lot No. , Recorded Plat
5. Private Claims

Grid table with columns A-M and rows 2-13. A black dot is located at the intersection of column H and row 3.

I, RAPHAEL LANDINI, in a field survey on OCTOBER 5, 19 93, do hereby certify that under requirements of P.A. 74, Michigan P.A. of 1970, the corner points mentioned in lines 1 and 2 above were in conformance with regulations and rules therefore as required in the current manual of survey instructions of the United States Department of the Interior, Bureau of Land Management or by a decree of a Court of Law and/or that the corner points mentioned in lines 3, 4 and 5 above were in conformance with the rules of the Michigan Board of Land Surveyors or by a Decree of a Court of Law; established, re-established, monumented, re-monumented, recovered, found as expressed below:

NOTE: Not more than 4 corners, all in the same town and range, may be recorded on this certificate.

A. Description of original monument and accessories and/or subsequent restoration:

Table listing monuments: G.L.O., W. OAK DO, WPA (1930S) IRON, 10" BUTTERNUT, USC & GS MON, TEL POLE, 20" MAPLE, 16" MAPLE with measurements and status (GONE).


B. Description of corner evidence found and/or method applied in restoring or reestablishing corner:

Table listing corner evidence: WAYNE COUNTY ROAD COMM. MON IN MON BOX JAN 1973, WAYNE COUNTY DPS ROADS SET PK NAIL FROM PREVIOUS WITNESSES with measurements and bearings.

C. Description of monument for corner and accessories established to perpetuate locating the position of the corner:

I-3 T4S R10E
SET STANDARD 4" DIA. X 36 CONC. MONUMENT WITH 3/8" IRON ROD; REMON. BRASS DISK WITH CAP RJL RLS 16933 IN MON BOX.
FOUND WCRC TAG NW SIDE DE POLE N47°E 72.74'
FOUND WCRC TAG SW SIDE DE POLE S52°E 73.97'
FOUND WCRC TAG NW SIDE DE POLE S46°W 76.50'
FOUND WCRC TAG SW SIDE DE POLE N44°W 72.71'

93 DEC 22 AM 10:21
FORESTER YOUNGBLOOD
REGISTER OF DEEDS
WAYNE COUNTY, MI

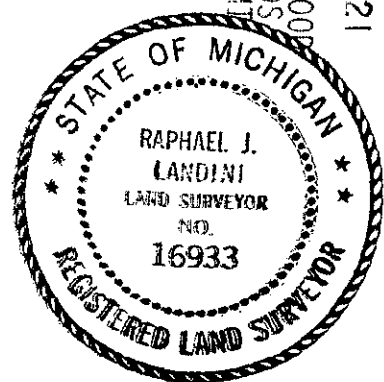

Signed by [Signature] Date DECEMBER 15, 1993
Surveyor's Michigan License No. 16933

Handwritten initials: 26 11/12/93