

**SURVEY &
REMONUMENTATION**

RC 1606

APR 25 1995

LAND CORNER RECORDATION CERTIFICATE
Filing Requirement of Act 74, Mich. P.A. 1970

\$ 13.00 MISCELLANEOUS RECORDING
28 DEC 94 9:41 A.M. RECEIVED
RECORDED
FOREST E. YOUNGBLOOD, REGISTERED LAND SURVEYOR
WAYNE COUNTY

COMMISSION

For corners in

WAYNE
(County)

Located in: Brownstown Corner Code #
Township

- | | | | |
|---------------------------------------|-------------|--------------|-----------|
| 1. Public Land Survey | T <u>4S</u> | R <u>10E</u> | <u>15</u> |
| | T _____ | R _____ | _____ |
| | T _____ | R _____ | _____ |
| | T _____ | R _____ | _____ |
| 2. Property Controlling
In Section | S _____ | T _____ | R _____ |
| | S _____ | T _____ | R _____ |
| 3. Miscellaneous
Property in Sec. | S _____ | T _____ | R _____ |
| | S _____ | T _____ | R _____ |

L127800P673

Compliance with
ACT 345, P.A. 1990


APPROVED ON: 12-7-94 *DBJ*
WAYNE COUNTY REMONUMENTATION
PEER GROUP COMMITTEE

Register of Deeds Stamp & File Number

RC 1606

4. Lot No. _____, Recorded Plat _____
5. Private Claims _____

I, Randy Kolehouse, in a field survey on October 24 19 94, do hereby certify that under requirements of P.A. 74 Michigan P.A. of 1970, the corner points mentioned in lines 1 and 2 above were in conformance with regulations and rules therefore as required in the current manual of survey instructions of the United States Department of the Interior, Bureau of Land Management or by a decree of a Court of Law and/or that the corner points mentioned in lines 3, 4 and 5 above were in conformance with the rules of the Michigan Board of Land Surveyors or by a Decree of a Court of Law; established, re-established, monumented, re-monumented, recovered, found as expressed below:

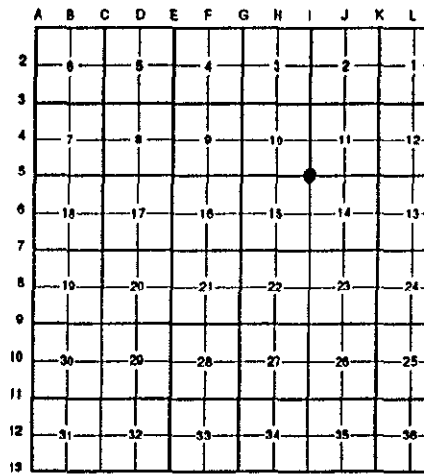

NOTE: Not more than 4 corners, all in the same town and range, may be recorded on this certificate.

A. Description of original monument and accessories and/or subsequent restoration:

1-5	1817	G.L.O. Notes	N/A	Post
	1930's	WPA Notes	N/A	Brass Plug
	1972	Cert. Survey L. 18285 P. 631 #406 WCRC	N/A	Arthurs Hand Hole Monument
	1973	WCRC Notes	N/A	1/2" Iron - Mon. in Box
	1978	Cert. Survey L. 20333 P. 842 CS #1528	Crossman	N/A
	1978	Cert Survey L. 20333 P. 843 CS #1529	Condon	Iron in Hand Hole

B. Description of corner evidence found and/or method applied in restoring or reestablishing corner:

1-5 I found 1" pipe in monument box at the center line intersection of King Road (concrete) running E-W and Allen Road (concrete) running N-S. Agrees with the following witnesses.

CS #1528
S 60° W 66.80' WCRC Nail & Cap in Lt. Pole (66.91' m)

WCRC
Nail & Tag D.E. Pole SE'ly 79.85' (80.00' m)
Nail & Tag D.E. Pole SW'ly 67.15' (66.91' m)


CS #1529
S 60° W 66.80' WCRC Nail & Cap in Lt. Pole (66.91' m)

Measures North to I-3 = 5265.73' (G.L.O. = 2640') (WPA = 5265.90' S-10 & 5265.79' S-11)
Measures East to J-5 = 2623.98' (G.L.O. = 2641.32') (WPA = 2620.60' S-11 & 2620.54' S-14)
Measures South to I-6 = 2637.62' (G.L.O. = 2640') (WPA = 2637.32' S-14 & 2637.05' S-15) (CS #405 = 2637.42')

C. Description of monument for corner and accessories established to perpetuate locating the position of the corner:

1-5 I replaced the 1" pipe with 1/2" rebar and aluminum cap stamped "Wayne Co. Remon." in an existing monument box.

P.K. NW Face Util. Pole N 49° E 75.00'
Nail w/Tag "WCRC" SW Face Util. Pole S 31° E 80.00'
Nail w/Tag "WCRC" SW Face Util. Pole S 61° W 66.91'
C/L Top Nut Hydrant N 26° W 88.70'

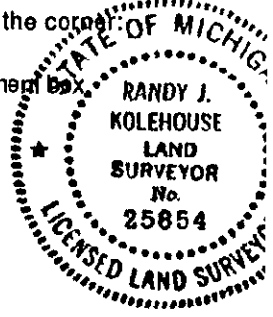

The selected location is accepted by the Contractor and is generally accepted by professional surveyors as the best available evidence of the position of the original corner.

Signed by Randy J. Kolehouse

Date 12/14/94

Surveyor's Michigan License No. 25854

28
11
M15