

SURVEY & REMONUMENTATION

RC 1607

APR 25 1995

COMMISSION

LAND CORNER RECORDATION CERTIFICATE
Filing Requirement of Act 74, Mich. P.A. 1970

\$ 13.00 MISCELLANEOUS RECORDING
28 DEC 94 9:41 A.M. RECEIPT# 167
RECORDED
FOREST E. WOODHOLM, REGISTERED PROFESSIONAL LAND SURVEYOR
STATE OF MICHIGAN

For corners in

<u>WAYNE</u> (County)	Located in: City of Wood Haven	Corner Code # I-9
1. Public Land Survey	T <u>4S</u> R <u>10E</u>	<u>I-9</u>
	T _____ R _____	_____
	T _____ R _____	_____
	T _____ R _____	_____
2. Property Controlling In Section	S _____ T _____ R _____	_____
	S _____ T _____ R _____	_____
3. Miscellaneous Property in Sec.	S _____ T _____ R _____	_____
	S _____ T _____ R _____	_____

LI27800PA674


Compliance with
ACT 345, P.A. 1990

APPROVED ON: 12-7-94 *DPJ*
WAYNE COUNTY REMONUMENTATION
PEER GROUP COMMITTEE

Register of Deeds Stamp & File Number

4. Lot No. _____, Recorded Plat _____
5. Private Claims _____

I, Randy Kolehouse, in a field survey on August 3 19 94, do hereby certify that under requirements of P.A. 74 Michigan P.A. of 1970, the corner points mentioned in lines 1 and 2 above were in conformance with regulations and rules therefore as required in the current manual of survey Instructions of the United States Department of the Interior, Bureau of Land Management or by a decree of a Court of Law and/or that the corner points mentioned in lines 3, 4 and 5 above were in conformance with the rules of the Michigan Board of Land Surveyors or by a Decree of a Court of Law; established, re-established, monumented, re-monumented, recovered, found as expressed below:

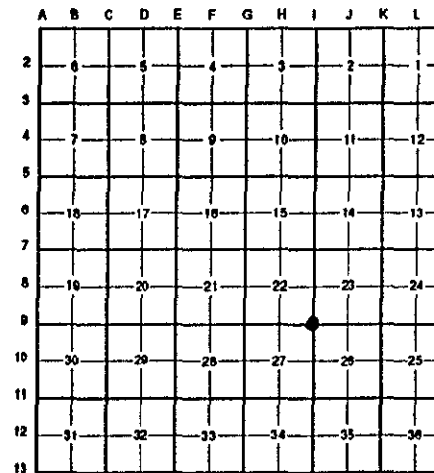

NOTE: Not more than 4 corners, all in the same town and range, may be recorded on this certificate.

A. Description of original monument and accessories and/or subsequent restoration:

1817	G.L.O. Notes	N/A	Post
1930's	WPA Notes	N/A	Cross
1973	WCRC Notes	N/A	Mon. in Box
1974	Cert. Survey & L.C.R.C. L. 18920 P. 163 #995 & L. 18956 P. 709 #359	Hughes	Monument in Road Box
1975	WCRC Notes	N/A	Monument in Road Box
1975	L.C.R.C. L. 19117 P. 487 #425 (WCRC)	Swanson	Monument in Mon. Box
1977	Cert. Survey L. 19873 P. 388 #1380	Arthurs	Concrete Mon. in Box
1977	L.C.R.C. L. 19882 P. 657 #541 (WCRC)	Swanson	"+" in New Concrete
1978	L.C.R.C. & Cert. Survey L. 20184 P. 878 & 873 CS #1500 L. 20202 P. 599 RC #606	Arthurs	Concrete Mon. in Box
			WCRC Hand Hole Mon.

B. Description of corner evidence found and/or method applied in restoring or reestablishing corner:

I-9 I found 1/2" rebar in monument box at the center line intersection of Van Horn Road (concrete) running E-W and Allen Road (concrete) running N-S which agrees with the following witnesses.

Cert. Survey #993 & L.C.R.C. #359	L.C.R.C. #541	L.C.R.C. #606 & CS #1500
Nail w/Tag "WCRC" SW Face Util. Pole S 30° E 75.49'	NE 81.10' Spike w/Brass Tag NW Side D.E. Pole	WCRC Shinner NW Side Util. Pole NE 81.22'
SE 75.45' Spike w/Brass Tag SW Side D.E. Pole	P.K. SW Side Util. Pole SE 75.50'	
SW 73.37' Spike w/Brass Tag NW Side D.E. Pole	WCRC Shinner NW Side Util. Pole SW 73.42'	
L.C.R.C. #425	CS #1380	
NE 81.18' Spike w/Brass Tag NW Side D.E. Pole	P.K. in Util. Pole SE 75.50'	
SE 75.48' Spike w/Brass Tag SW Side D.E. Pole	WCRC Shinner Util. Pole NE 81.22'	
	WCRC Shinner Util. Pole SW 73.42'	


Measures South to I-10 = 2643.84' (G.L.O. = 2640') (WPA = 2643.77'
Measures West to H-9 = 2804.19' (G.L.O. = 2706') (WPA = 2805.24' S-22 & 2805.10' S-27) (CS #1500 = 2805.40')
Measures North to I-8 = 2639.31' (G.L.O. = 2640') (WPA = 2639.19' S-22 & 2639.36' S-23)

C. Description of monument for corner and accessories established to perpetuate locating the position of the corner:

I-9 Set an aluminum cap stamped "Wayne Co. Remon." on existing 1/2" rebar in an existing monument box.

Nail w/Tag "WCRC" NW Face Util. Pole N 43° E 81.04'
P.K. SW Face Util. Pole S 39° E 75.53'
Nail w/Tag "WCRC" NW Face Util. Pole S 52° W 73.28'
P.K. NE Face Util. Pole N 68° W 63.46'

The selected location is accepted by the Contractor and is generally accepted by professional surveyors as the best available evidence of the position of the original corner.

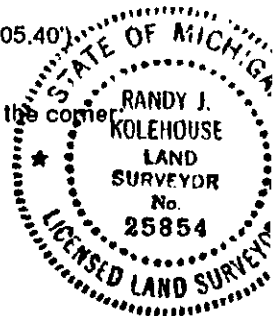

Signed by Randy J. Kolehouse Date 12/14/94
Surveyor's Michigan License No. 25854