

SURVEY & REMONUMENTATION

RC 1608

APR 25 1995

\$ 13.00 MISCELLANEOUS RECORDING
28 DEC 94 9:42 A.M. RECEIPT# 160
RECORDED
FOREST E. VONPARLOW, REGISTER OF DEEDS
WAYNE COUNTY, MI

COMMISSION

LAND CORNER RECORDATION CERTIFICATE
Filing Requirement of Act 74, Mich. P.A. 1970

For corners in

<u>WAYNE</u> (County)	Located in: <u>Brownstown</u> Township	Corner Code # <u>I-11</u>
1. Public Land Survey	T <u>4S</u> R <u>10E</u>	<u>I-11</u>
	T _____ R _____	_____
	T _____ R _____	_____
	T _____ R _____	_____
2. Property Controlling in Section	S _____ T _____ R _____	_____
	S _____ T _____ R _____	_____
3. Miscellaneous Property in Sec.	S _____ T _____ R _____	_____
	S _____ T _____ R _____	_____
4. Lot No. _____, Recorded Plat _____		
5. Private Claims _____		

LC 7800PA67

Compliance with ACT 345, P.A. 1990


APPROVED ON: 12-7-94 DBJ.
WAYNE COUNTY REMONUMENTATION
PEER GROUP COMMITTEE

Register of Deeds Stamp & File Number

RC 1608

I, Randy Kolehouse, in a field survey on August 8 19 94, do hereby certify that under requirements of P.A. 74 Michigan P.A. of 1970, the corner points mentioned in lines 1 and 2 above were in conformance with regulations and rules therefore as required in the current manual of survey instructions of the United States Department of the Interior, Bureau of Land Management or by a decree of a Court of Law and/or that the corner points mentioned in lines 3, 4 and 5 above were in conformance with the rules of the Michigan Board of Land Surveyors or by a Decree of a Court of Law; established, re-established, monumented, re-monumented, recovered, found as expressed below:

NOTE: Not more than 4 corners, all in the same town and range, may be recorded on this certificate.

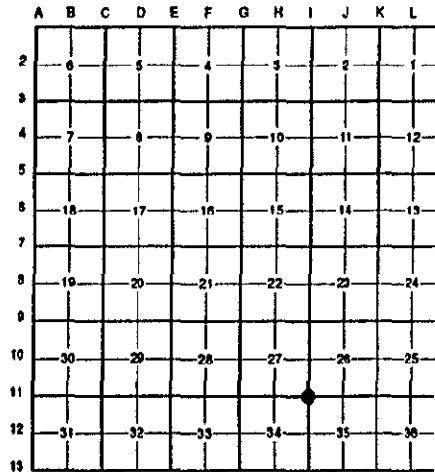

A. Description of original monument and accessories and/or subsequent restoration:

I-11	1817	G.L.O. Notes	N/A	Post
	1930's	WPA Notes	N/A	Iron
	1971	L.C.R.C. L. 18258 P. 250 RC #153	Wade	Iron in Concrete
	1973	WCRC Notes	N/A	Iron in Mon. Box
	1975	Cert. Survey L. 19211 P. 222 CS #1159	Stanley	N/A
	1976	Cert. Survey L. 19388 P. 368 CS #1206	Stanley	N/A
	1977	Cert. Survey L. 19813 P. 736-738 CS #1325	Arthurs	WCRC Mon.
	1979	Cert. Survey L. 20___ P. 936 CS #1592	Arthurs	WCRC Hand Hole Mon.
	1980	Cert. Survey L. 20876 P. 654 CS 1668	Arthurs	N/A

B. Description of corner evidence found and/or method applied in restoring or reestablishing corner:

I-11 I found 1/2" rebar in monument box at the center line intersection of Allen Road (asphalt) running N-S and Vreeland Road (asphalt) running E-W which agrees with the following witnesses.

Cert. Survey #1325 & CS #1592	WCRC
P.K. in SE Side Util. Pole NE'ly 64.63'	Nail & Tag D.E. Pole SE'ly 63.80' (63.66' m)
WCRC Shinner NE Side Util. Pole SE'ly 63.77'	Nail & Tag D.E. Pole SW'ly 90.20' (90.19' m)
WCRC Shinner NW Side Util. Pole SW'ly 90.20'	Nail & Tag D.E. Pole NE'ly 64.83' (64.59' m)


Measures North to I-10 = 2643.57" (G.L.O. = 2640') (WPA = 2643.42' S-26 - 2643.44' S-27)
Measures South to I-12 = 2629.23' (G.L.O. = 2640') (WPA = 3284.17') (CS #1325 = 2629.29'
Measures East to J-11 = 2616.87 (G.L.O. = 2643.96') (WPA = 2618.05 S-26 - 2618.12' S-35) (CS #1325 = 2617.36' - CS #1668 = 2637.36')
Measures West to H-11 = 2923.35' (G.L.O. = 2712.60') (WPA = 2923.00') (CS #1206 = 2917.69' - CS #1159 = 2917.69' - CS #1592 = 2922.99')

C. Description of monument for corner and accessories established to perpetuate locating the position of the corner:

I-11 Set aluminum cap stamped "Wayne Co. Remon." on existing 1/2" rebar in an existing monument box.

P.K. SE Face Util. Pole N 51° E 64.48'
Nail w/Tag "WCRC" NE Face Util. Pole S 47° E 63.66'
Nail w/Tag "WCRC" NW Face Util. Pole S 49° W 90.19'
Nail w/Tag "WCR" S Face Util. Pole N 77° W 135.10'

The selected location is accepted by the Contractor and is generally accepted by professional surveyors as the best available evidence of the position of the original corner.

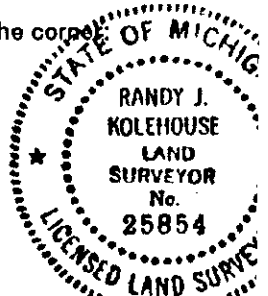

Signed by Randy J. Kolehouse Date 12/14/94
Surveyor's Michigan License No. 25854