

**LAND CORNER RECORDATION CERTIFICATE**  
**Filing Requirement of Act 74, Mich. P.A. 1970**

**LI29360PA588**

For corners in

<u>WAYNE</u> (County)	Located in: City of Riverview	Corner Code # K-3
1. Public Land Survey	T <u>4S</u> R <u>10E</u>	<u>K-3</u>
	T _____ R _____	_____
	T _____ R _____	_____
	T _____ R _____	_____
2. Property Controlling in Section	S _____ T _____ R _____	_____
	S _____ T _____ R _____	_____
3. Miscellaneous Property in Sec.	S _____ T _____ R _____	_____
	S _____ T _____ R _____	_____
4. Lot No. _____, Recorded Plat _____		
5. Private Claims _____		

Compliance with  
**ACT 345, P.A. 1990**


APPROVED ON: DEC. 17, 1996

**WAYNE COUNTY REMONUMENTATION  
 PEER GROUP COMMITTEE**

Register of Deeds Stamp & File Number

96326802

I, Randy Kolehouse, in a field survey on September 3 19 93, do hereby certify that under requirements of P.A. 74 Michigan P.A. of 1970, the corner points mentioned in lines 1 and 2 above were in conformance with regulations and rules therefore as required in the current manual of survey instructions of the United States Department of the interior, Bureau of Land Management or by a decree of a Court of Law and/or that the corner points mentioned in lines 3, 4 and 5 above were in conformance with the rules of the Michigan Board of Land Surveyors or by a Decree of a Court of Law; established, re-established, monumented, re-monumented, recovered, found as expressed below:

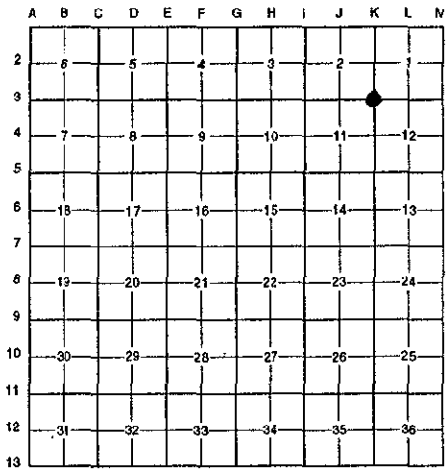

**NOTE: Not more than 4 corners, all in the same town and range, may be recorded on this certificate.**

**A. Description of original monument and accessories and/or subsequent restoration:**

K-3	1817	G.L.O. Notes	Wampler	Set Post
	1930	WPA Survey & Witness	N/A	N/A
	1978	L.C.R.C. L. #20282 P. 188	Callahan #13576	Conc. Mon. in Mon. Box

**B. Description of corner evidence found and/or method applied in restoring or reestablishing corner:**

K-3 Found a 1/2" rebar in a 4" concrete monument in a monument box in the center line of Sibley Road (bituminous) running East and West. Checks one remaining witness from WPA witness and one witness from L.C.R.C. L. 20282 P. 188

WPA Witness  
 Tele. Pole SE 74.61' (m. 74.77')

L.C.R.C. #20282 P. 188  
 Tele. Pole S 64° E 74.76' (74.77')

**\$ 4.00 REMONUMENTATION**  
**\$ 7.00 DEED**  
 26 DEC 96 12:45 P.M. RECEI A  
 RECORDED  
 FOREST E. YOUNGBLOOD, REGISTER EDS  
 WAYNE COUNTY, MI

Measures West to J-3 = 2636.81' (WPA = 2636.72')  
 Measures North to K-2 = 2668.99' (WPA = 2669.14')  
 Measures East to L-3 = 2562.10' (WPA = 2561.88')

**C. Description of monument for corner and accessories established to perpetuate locating the position of the corner:**

K-3 Set a Wayne County marker on an existing concrete monument in a monument box.

P.K. Nail N Face P. Pole N 50° W 80.66'  
 Nail w/Tag "WCRC" S Face P. Pole N 60° E 73.08'  
 Nail w/Tag "WCRC" SW Face Tele. Pole S 60° E 74.77'  
 Top C/L Hyd. S 25° W 31.35'



The selected location is accepted by the Contractor and is generally accepted by professional surveyors as the best available evidence of the position of the original corner.

Signed by Randy J. Kolehouse Date 11/25/96  
 Surveyor's Michigan License No. 25854