

SURVEY & REMONUMENTATION

Per Co. Rep - T & R should be T4S, R10E re-recorded in L30179, Pg 2233.0 to correct.

DEC 02 1993

COMMISSION

**RC 1112
LAND CORNER RECORDATION CERTIFICATE
Filing Requirement of Act 74, Mich. P.A. 1970**

LI25951 PA 743

For corners in
Wayne
(County)

Located In: Corner Code #

- | | | |
|------------------------------------|-------------------------|----------------|
| 1. Public Land Survey | T <u>4S</u> R <u>9E</u> | <u>K-11</u> |
| | T _____ R _____ | _____ |
| | T _____ R _____ | <u>Seg. #1</u> |
| | T _____ R _____ | _____ |
| 2. Property Controlling in Section | S _____ T _____ R _____ | _____ |
| | S _____ T _____ R _____ | _____ |
| 3. Miscellaneous Property in Sec. | S _____ T _____ R _____ | _____ |
| | S _____ T _____ R _____ | _____ |
4. Lot No. _____, Recorded Plat _____
5. Private Claims _____

Compliance with
ACT 345, P.A. 1990
APPROVED ON: 10-28-93 *DJ*
WAYNE COUNTY REMONUMENTATION
PEER GROUP COMMITTEE

Register of Deeds Stamp & File Number

RC 1112

I, Bruce Antcliff, in a field survey on August 25, 1993, do hereby certify that under requirements of P.A. 74, Michigan P.A. of 1970, the corner points mentioned in lines 1 and 2 above were in conformance with regulations and rules therefor as required in the current manual of survey instructions of the United States Department of the Interior, Bureau of Land Management or by a decree of a Court of Law and/or that the corner points mentioned in lines 3, 4 and 5 above were in conformance with the rules of the Michigan Board of Land Surveyors or by a Decree of a Court of Law; established, re-established, monumented, re-monumented, recovered, found as expressed below:

	A	B	C	D	E	F	G	H	I	J	K	L	M
2	6	5	4	3	2	1							
3													
4	7	8	9	10	11	12							
5													
6	18	17	16	15	14	13							
7													
8	19	20	21	22	23	24							
9													
10	30	29	28	27	26	25							
11													
12	31	32	33	34	35	36							
13													

NOTE: Not more than 4 corners, all in the same town and range, may be recorded on this certificate.

A. Description of original monument and accessories and/or subsequent restoration:

GLO-Post
WPA (1930's) - Monument

B. Description of corner evidence found and/or method applied in restoring or reestablishing corner:

1/2" Rebar/Conc. Mon. in Mon. Box; Measured to S1/4 S.25 & S1/4 S.26 - Distances checked well with WPA Surveys

C. Description of monument for corner and accessories established to perpetuate locating the position of the corner:


Set Wayne County Remonumentation Marker and Cap #25826 on existing monument

Witnesses

- P.K. in SE Face Tel. Pole, NE, 56.98'
- 1/2" Drill Hole W. End conc. Bridge Abut., ENE, 61.31'
- 1/2" Drill Hole W. End Conc. Bridge Abut., ESE, 59.89'
- P.K. in SW Face Tel. Pole, WNW, 52.49'

The selected location is accepted by the Contractor and is generally accepted by professional surveyors as the best available evidence of the position of the original corner.

Signed by Bruce Antcliff Date 11-10-93
Surveyor's Michigan License No. 25826

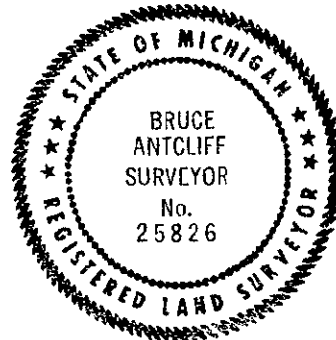

*25826
119*