

JUN 21 1999

FILE DO NOT M...

LAND CORNER RECORDATION CERTIFICATE  
Filing Requirement of Act 74, Mich. P.A. 1970

For corners in

<u>Wayne</u> (County)	Located in: <u>Brownstown</u>	Corner Code #
1. Public Land Survey	T <u>4S</u> R <u>10E</u>	<u>K-11</u>
	T _____ R _____	_____
	T _____ R _____	_____
	T _____ R _____	<u>Seg. #2</u>
2. Property Controlling in Section	S _____ T _____ R _____	_____
	S _____ T _____ R _____	_____
3. Miscellaneous Property in Sec.	S _____ T _____ R _____	_____
	S _____ T _____ R _____	_____

Compliance with ACT 345, P.A. 1990

APPROVED ON: 6-21-99 *P.P.*

WAYNE COUNTY REMONUMENTATION PEER GROUP COMMITTEE

Register of Deeds Stamp & File Number

- 4. Lot No. \_\_\_\_\_, Recorded Plat \_\_\_\_\_
- 5. Private Claims \_\_\_\_\_

I, Bruce Antcliff, in a field survey on August 25 19 93, do hereby certify that under requirements of P.A. 74 Michigan P.A. of 1970, the corner points mentioned in lines 1 and 2 above were in conformance with regulations and rules therefore as required in the current manual of survey instructions of the United States Department of the interior, Bureau of Land Management or by a decree of a Court of Law and/or that the corner points mentioned in lines 3, 4 and 5 above were in conformance with the rules of the Michigan Board of Land Surveyors or by a Decree of a Court of Law; established, re-established, monumented, re-monumented, recovered, found as expressed below:

A	B	C	D	E	F	G	H	I	J	K	L	M
2	6		5		4		3		2		1	
3												
4	7		8		9		10		11		12	
5												
6	16		17		18		15		14		13	
7												
8	19		20		21		22		23		24	
9												
10	30		29		28		27		26		25	
11												
12	31		32		33		34		35		36	
13												

NOTE: Not more than 4 corners, all in the same town and range, may be recorded on this certificate.

A. Description of original monument and accessories and/or subsequent restoration:

GLO-Post  
WPA (1930's) - Monument

RECEIPT# 2122  
\$7.00 D  
\$4.00 REMO

RECORDED  
FOREST E. YOUNGBLOOD  
REGISTER OF DEEDS  
WAYNE COUNTY, MI

B. Description of corner evidence found and/or method applied in restoring or reestablishing corner:

1/2" Rebar/Conc. Mon. in Mon. Box; Measured to S1/4 S.25 & S1/4 S.26  
Distances checked well with WPA Surveys

SURVEY &  
REMONUMENTATION  
JUL 01 1999  
SECTION


C. Description of monument for corner and accessories established to perpetuate locating the position of the corner:

Re-record to Correct Previous L.C.R.C. L. 26951, P. 743

Set Wayne County Remonumentation Marker and Cap #25826 on existing monument

Witnesses

- P.K. in SE Face Tel. Pole NE, 56.98'
- 1/2" Drill Hole W. End Conc. Bridge Abut., ENE, 61.31'
- 1/2" Drill Hole W. End Conc. Bridge Abut., ESE, 59.89'
- P.K. in SW Face Tel. Pole, WNW, 52.49'

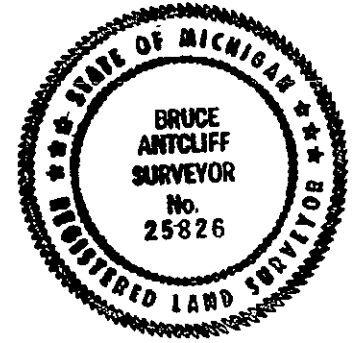

The selected location is accepted by me and is generally accepted by professional surveyors as the best available evidence of the position of the original corner.

Signed by Bruce Antcliff Date 6-14-99

Surveyor's Michigan License No. 25826

LCR  
RTAC 7 CR 1pg 4 gm