

**SURVEY & REMONUMENTATION**

**LAND CORNER RECORDATION CERTIFICATE**  
 Filing Requirement of Act 74, Mich. P.A. 1970

APR 05 1996

For corners in

Wayne Co. COMMISSION located in: \_\_\_\_\_ Corner Code #  
 (County) \_\_\_\_\_ City of Trenton

LIBER 28451 PAGE 502


Compliance with  
 ACT 345, P.A. 1990

APPROVED ON: 11-28-95 *DRZ*  
 WAYNE COUNTY REMONUMENTATION  
 PEER GROUP COMMITTEE

Register of Deeds Stamp & File Number

- |                                    |              |               |             |
|------------------------------------|--------------|---------------|-------------|
| 1. Public Land Survey              | T <u>4</u> S | R <u>10</u> E | <u>L-11</u> |
|                                    | T _____      | R _____       | _____       |
|                                    | T _____      | R _____       | _____       |
|                                    | T _____      | R _____       | _____       |
| 2. Property Controlling in Section | S _____      | T _____       | R _____     |
|                                    | S _____      | T _____       | R _____     |
| 3. Miscellaneous Property in Sec.  | S _____      | T _____       | R _____     |
|                                    | S _____      | T _____       | R _____     |

4. Lot No. \_\_\_\_\_, Recorded Plat \_\_\_\_\_  
 5. Private Claims \_\_\_\_\_

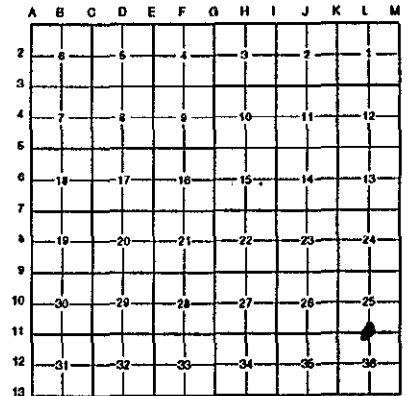

I, Randy Kolehouse, in a field survey on Nov. 3 1995, do hereby certify that under requirements of P.A. 74 Michigan P.A. of 1970, the corner points mentioned in lines 1 and 2 above were in conformance with regulations and rules therefore as required in the current manual of survey instructions of the United States Department of the Interior, Bureau of Land Management or by a decree of a Court of Law and/or that the corner points mentioned in lines 3, 4 and 5 above were in conformance with the rules of the Michigan Board of Land Surveyors or by a Decree of a Court of Law; established, re-established, monumented, re-monumented, recovered, found as expressed below:

**NOTE: Not more than 4 corners, all in the same town and range, may be recorded on this certificate.**

**A. Description of original monument and accessories and/or subsequent restoration:**

L-11	1817	GLO	Notes
	1930's	WPA	Unknown Section map and ties

\$ 4.00 REMONUMENTATION  
 Post \$ 7.00 DEED  
 Mon. DEC 95 12:39 P.M. RECEIP  
 RECORDED  
 FOREST E. YOUNGBLOOD, REGISTER  
 WAYNE COUNTY, MI EDS  
 45262457

**B. Description of corner evidence found and/or method applied in restoring or reestablishing corner:**

-11 I found a 1/2" ID pipe in an existing monument box at the centerline of Vreeland Rd. (asphalt) and 10' east of the centerline of Hoover Rd. (asph.).

Measures east to M-11 T4S,R10E = 2569.17' (GLO = 2640.66'),(WPA =2568.79')  
 Measures west to K-11 T4S,R10E = 2622.58' (GLO = 2640.66'),(WPA =2623.03')  
 Measures east to a monument at Jefferson Ave. = 771.90' (WPA =771.87')


**C. Description of monument for corner and accessories established to perpetuate locating the position of the corner:**

-11 Replaced 1/2" pipe with a 2" aluminum cap stamped "Wayne County Remonumentation #25854" on a 1/2" x 36" re-bar in existing monument box.

PK nail S face 18" Beech	N64°E	56.61'
PK Nail in NW. face guy pole	S63°W	63.02'
Top nut fire hydrant	N72°W	78.41'
PK Nail in E face p. pole	N52°W	60.00'

The selected location is accepted by the Contractor and is generally accepted by professional surveyors as the best available evidence of the position of the original corner.

igned by Randy J. Kolehouse Date 12/2/95  
 Surveyor's Michigan License No. 25854

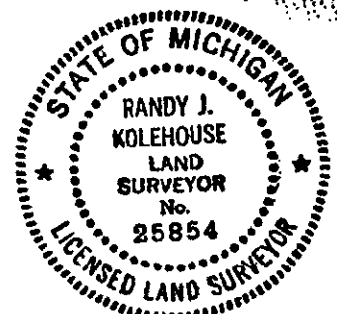

4R  
 7D  
 7J