

**SURVEY & REMONUMENTATION**

APR 25 1995

**RC 1612**

**COMMISSION**

**LAND CORNER RECORDATION CERTIFICATE**  
Filing Requirement of Act 74, Mich. P.A. 1970

LI27800PA679

For corners in

Wayne (County)	Located in: City of Trenton	Corner Code #
1. Public Land Survey	T <u>4S</u> R <u>10E</u>	<u>M-5</u>
	T _____ R _____	_____
	T _____ R _____	_____
	T _____ R _____	_____
2. Property Controlling in Section	S _____ T _____ R _____	_____
	S _____ T _____ R _____	_____
3. Miscellaneous Property in Sec.	S _____ T _____ R _____	_____
	S _____ T _____ R _____	_____
4. Lot No. _____, Recorded Plat _____		
5. Private Claims _____		

Compliance with ACT 345, P.A. 1990  
APPROVED ON: 12-7-94 *DBJ.*  
WAYNE COUNTY REMONUMENTATION PEER GROUP COMMITTEE

Register of Deeds Stamp & File Number

RC 1612

I, Randy Kolehouse, in a field survey on August 3 19 94, do hereby certify that under requirements of P.A. 74 Michigan P.A. of 1970, the corner points mentioned in lines 1 and 2 above were in conformance with regulations and rules therefore as required in the current manual of survey instructions of the United States Department of the Interior, Bureau of Land Management or by a decree of a Court of Law and/or that the corner points mentioned in lines 3, 4 and 5 above were in conformance with the rules of the Michigan Board of Land Surveyors or by a Decree of a Court of Law; established, re-established, monumented, re-monumented, recovered, found as expressed below:

	A	B	C	D	E	F	G	H	I	J	K	L
2	6		5		4		3		2		1	
3												
4	7		8		9		10		11		12	
5												
6	18		17		16		15		14		13	
7												
8	19		20		21		22		23		24	
9												
10	30		29		28		27		26		25	
11												
12	31		32		33		34		35		36	
13												

NOTE: Not more than 4 corners, all in the same town and range, may be recorded on this certificate.

A. Description of original monument and accessories and/or subsequent restoration:

M-5	1817	G.L.O. Notes	N/A	Post
	1930's	WPA Notes	N/A	Iron
	1978	Cert. Survey L. 20074 P. 305	Arthurs	WCRC Hand Hole Mon.
	1983	L.C.R.C. L. 21944 P. 553 RC #831	Young	Iron Pin in Mon. Box

B. Description of corner evidence found and/or method applied in restoring or reestablishing corner:

M-5 I found 1" pipe in monument box 5' South of C/L of King Road (concrete) running E-W and 10' West of C/L N.B. Fort Street (concrete) which agrees with the following witnesses.

L.C.R.C. RC #831  
S 45° W 40.45' P.K. & Tag NW Face Util. Pole  
S 40° E 65.65' P.K. & Tag SW Face D.E. Co. Pole


Measures South to M-7 = 5285.84' (G.L.O. = 5280') (WPA = 5284.78')  
Measures West to L-5 = 2595.92' (G.L.O. = 2627.79') (WPA = 2595.21' S-12)  
Measures North to M-3 = 5299.80' (G.L.O. = 5280') (WPA = 5299.50')

\$ 13.00 MISCELLANEOUS RECORDING  
28 DEC 94 9:42 A.M. RECEIPT# 168  
RECORDED  
FOREST E. YOUNGLOOD, REGISTER OF DEEDS  
WAYNE COUNTY, MI

C. Description of monument for corner and accessories established to perpetuate locating the position of the corner:

M-5 Replaced 1" pipe with 1/2" rebar and aluminum cap stamped "Wayne Co. Remon." in an existing monument box.

Nail w/Tag "GLA #26400" NW Face Util. Pole N 50° E 71.90'  
Nail w/Tag "RLS #19837" SW Face Util. Pole S 46° E 65.60'  
Nail w/Tag "GLA #26400" NW Face Util. Pole S 35° W 40.47'  
Nail w/Tag "RLS #19837" SW Face Util. Pole N 54° W 99.89'

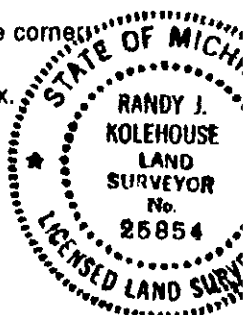

The selected location is accepted by the Contractor and is generally accepted by professional surveyors as the best available evidence of the position of the original corner.

Signed by Randy J. Kolehouse  
Surveyor's Michigan License No. 25854

Date 12/14/94

2 R  
11 D  
11 S