

SURVEY & MONUMENTATION

APR 05 1996

COMMISSION

LAND CORNER RECORDATION CERTIFICATE
Filing Requirement of Act 74, Mich. P.A. 1970

For corners in

<u>WAYNE</u> (County)	Located in: City of Trenton	Corner Code #
1. Public Land Survey	T <u>4S</u> R <u>10E</u>	<u>M-7</u>
	T _____ R _____	_____
	T _____ R _____	_____
	T _____ R _____	_____
2. Property Controlling in Section	S _____ T _____ R _____	_____
	S _____ T _____ R _____	_____
3. Miscellaneous Property in Sec.	S _____ T _____ R _____	_____
	S _____ T _____ R _____	_____

LIBER 28451 PAGE 503

Compliance with ACT 345, P.A. 1990

APPROVED ON: 11-28-95 *JG*
WAYNE COUNTY REMONUMENTATION PEER GROUP COMMITTEE

Register of Deeds Stamp & File Number

4. Lot No. _____, Recorded Plat _____
5. Private Claims _____

I, Randy Kolehouse, in a field survey on October 24 19 94, do hereby certify that under requirements of P.A. 74 Michigan P.A. of 1970, the corner points mentioned in lines 1 and 2 above were in conformance with regulations and rules therefore as required in the current manual of survey instructions of the United States Department of the Interior, Bureau of Land Management or by a decree of a Court of Law and/or that the corner points mentioned in lines 3, 4 and 5 above were in conformance with the rules of the Michigan Board of Land Surveyors or by a Decree of a Court of Law; established, re-established, monumented, re-monumented, recovered, found as expressed below:

NOTE: Not more than 4 corners, all in the same town and range, may be recorded on this certificate.

A. Description of original monument and accessories and/or subsequent restoration:

M-7 1817 G.L.O. Notes N/A Post
1930's WPA Notes N/A Iron

	A	B	C	D	E	F	G	H	I	J	K	L	M
2	6	5	4	3	2	1							
3													
4	7	8	9	10	11	12							
5													
6	18	17	16	15	14	13							
7													
8	19	20	21	22	23	24							
9													
10	30	29	28	27	26	25							
11													
12	31	32	33	34	35	36							

\$ 9.00 REMONUMENTATION
\$ 7.00 DEED
8 DEC 95 12:39 P.M. RECEIP
RECORDED
FOREST E. YOUNGBLOOD, REGISTER ED S
WAYNE COUNTY, MI

45262458

B. Description of corner evidence found and/or method applied in restoring or reestablishing corner:

M-7 I found a P.K. nail at the intersection of West Road (asphalt) running E-W and Veterans Parkway (asphalt) running North which agrees with the following witnesses.

WPA
Edison Pole NW'ly 76.42'

*THIS CORNER IS COMMON TO
A-7 T 4S R 11E.*


Measures West to L-7 = 2615.88' (G.L.O. = 2633.73') (WPA = 2615.75')
Measure North to M-5 = 5285.84' (G.L.O. = 5280') (WPA = 5284.78')

C. Description of monument for corner and accessories established to perpetuate locating the position of the corner:

M-7 Replaced P.K. with 1/2" rebar and aluminum cap stamped "Wayne Co. Remon."

Nail w/Tag "WCRC" SE Face Util. Pole N 30° E 67.26'
P.K. SW Face Util. Pole S 63° E 73.03'
NW Cor. Brick Bldg. #1595 West Road S 27° W 101.81'
P.K. in NE Face Util. Pole N 63° W 76.39'

*5 SHOULD HAVE
BEEN PUT
IN NEW
ROAD BOX
DO NOT SEND
TO STATE*

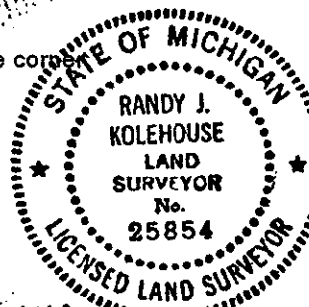

The selected location is accepted by the Contractor and is generally accepted by professional surveyors as the best available evidence of the position of the original corner.

Signed by Randy J. Kolehouse
Surveyor's Michigan License No. 25854

Date 12/2/95

42
70
JG