

LAND CORNER RECORDATION CERTIFICATE
Filing Requirements of Act. 74, Mich. P.A. 1970

FILE DO NOT MAIL
For corners in

Liber-30864 Page-10
99595564 12/30/1999
F.E. Youngblood, Wayne Co. Register of Deeds

Wayne (County) Located in: City of Flat Rock Corner Code #

Table with 3 columns: Survey Type, Township/Range/Elevation, and Corner Code. Includes entries for Public Land Survey, Property Controlling in Section, and Miscellaneous Property in Sec.

Compliance with ACT 345, P.A. 1990

APPROVED ON: 12-8-99
WAYNE COUNTY REMONUMENTATION PEER GROUP COMMITTEE

Register of Deeds Stamp & File Number

4. Lot No. Recorded Plat
5. Private Claims

I, Michael S. Hoben, in a field survey on Sept. 16, 1999 do hereby state that under requirements of P.A. 74, Michigan P.A. of 1970, the corner points mentioned in lines 1 and 2 above were in conformance with regulations and rules therefore as required in the current manual of survey instructions of the United States Department of the Interior, Bureau of Land Management or by a decree of a Court of Law and/or that the corner points mentioned in lines 3, 4 and 5 above were in conformance with the rules of the Michigan Board of Land Surveyors or by a Decree of a Court of Law; established, re-established, monumented, recovered, found as expressed below:

NOTE: Not more than 2 corners, all in the same town and range, may be recorded on this certificate.

A. Description of original monument and accessories and/or subsequent restoration:

Table listing survey notes (A-11 1817 GLO Notes), previous monuments (Preston Post, 1930's WPA, 1940 Supervisor's Brownstown Plat, 1973 WCRC, 1976 LCRC L. 19461, P. 704, 1977 LCRC L. 19632, P. 929, 1994 LCRC L. 27800, P. 664), and monument details (Stone, Iron flush w/top of A. C. 1/2" pipe in Mon. box, 21584 found mon. in road box, set W.C.R. cap on Mon. in box).

B. Description of corner evidence found and/or method applied in restoring or reestablishing corner:

A-11 I found a W. C. Remonumentation cap on a concrete Mon. in a Mon. box, on the centerline of Inkster RD. (asph.). This corner is now common with M-11 T4SR9E Huron Twp. GLO had set this corner 17.82' north of M-11. WPA shows this corner as being common (the distance N of Huron River Drive is the same in Brownstown and Huron Townships). Agrees with the following witnesses:


- SE SW corner house #27009 94.63'M (WCRC - 94.66') SE PK w/WCRC tag Util. Pole 66.48'M (WCRC = 66.70)(LCRC'94 = 66.48')
W NE corner house #27004 89.91'M (LCRC'94 = 90.0')
NW Nail & WCRC tag Util. Pole 85.63'M (WCRC = 85.77')(LCRC'76 = 85.74')(LCRC'77 = 85.75')(LCRC'94 = 85.68')
Distance to A-10 = 2607.67' (GLO = 2622.18')(WPA = 2607.66')
Distance to I-13 = 2657.51' (GLO = 2657.82')(WPA = 2649.62')

B. Description of monument for corner and accessories established to perpetuate locating the position of the corner:

A-11 I accepted the 2" aluminum cap stamped "Wayne County Monument MI Act 345 #25854" on the existing conc. Mon. in an existing monument box.

- S 45° E 94.63' SW corner brick house #27009
S 15° E 6848' FD. PK w/WCRC tag W'ly face Util. pole
S 59° W 93.49' NE corner house #27016
N 69° W 89.91' NE corner house #27004
N 12° W 85.63' FD. Nail w/WCRC tag NE'ly face Util. pole

The selected location is accepted by me and is generally accepted by Professional Surveyors as the best available evidence of the position of the original corner.

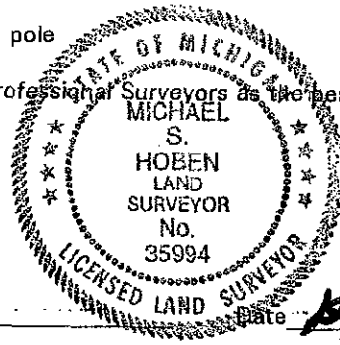

SURVEY &
RECORDS
FEB 28 2000

Signed by Michael S. Hoben
Surveyor's Michigan License No. 35994

FORM APPROVED BY MICHIGAN STATE BOARD OF LAND SURVEYORS, JAN. 28, 1971

REVISED MAY 14, 1975
REVISED JAN., 1983
REVISED OCT., 1999

R LCR 12 4R Z Pgs. A. [Signature]