

FEB 28 1994

For corners in

COMMISSION

LI 27042 PA 333

Compliance with  
ACT 345, P.A. 1990

APPROVED ON: 12-15-93 JPD.  
WAYNE COUNTY REMONUMENTATION  
PEER GROUP COMMITTEE

Register of Deeds Stamp & File Number

Wayne  
County:  
MONGUAGON TOWNSHIP #19

Located in: Corner Code #

1. Public Land Survey	T 4 S	R 11 E	A-01
	T	R	
	T	R	
	T	R	
2. Property Controlling in Section	S	T	R
	S	T	R
3. Miscellaneous Property in Sec.	S	T	R
	S	T	R

4. Lot No. \_\_\_\_\_, Recorded Plat \_\_\_\_\_

5. Private Claims \_\_\_\_\_

I, Kenneth S. Wilkerson, in a field survey on October 28, 19 93, do hereby certify that under requirements of P.A. 74, Michigan P.A. of 1970, the corner points mentioned in lines 1 and 2 above were in conformance with regulations and rules therefore as required in the current manual of survey instructions of the United States Department of the Interior, Bureau of Land Management or by a decree of a Court of Law and/or that the corner points mentioned in lines 3, 4 and 5 above were in conformance with the rules of the Michigan Board of Land Surveyors or by a Decree of a Court of Law; established, re-established, monumented, re-monumented, recovered, found as expressed below:

NOTE: Not more than 4 corners, all in the same town and range, may be recorded on this certificate.

A. Description of original monument and accessories and/or subsequent restoration:

A-01 Set Post - GLO - NO GLO WITNESSES REMAIN  
Iron - B of T  
Fd. mon box, L. 18787, P. 706 - 4/01/74

N 48 E 73.22 PP - Not Found  
S 45 E 48.82 PP - Not Found  
S 50 W 87.12 PP - Not Found

B. Description of corner evidence found and/or method applied in restoring or reestablishing corner:

A-01 Fd. 1/2" iron in mon box

Verified based on description and observations, per L 18787, P. 706 and is accepted as the best available evidence of the position of the original corner.

C. Description of monument for corner and accessories established to perpetuate locating the position of the corner:

Set Wayne County remonumentation washer and OHM - KSW 21584 cap on iron.

A-01 044 AZ 75.09 SET IRON ROD OHM TRAV CAP  
058 AZ 72.49 - OHM WASHER IN N FACE PP  
132 AZ 52.17 - TOP NUT ON HYD  
144 AZ 48.80 - OHM WASHER IN E FACE PP

The selected location is accepted as the best evidence of the position of the original corner.

A	B	C	D	E	F	G	H	I	J	K	L	M
2	6	5	4	3	2	1						
3												
4	7	8	9	10	11	12						
5												
6	18	17	16	15	14	13						
7												
8	19	20	21	22	23	24						
9												
10	30	29	28	27	26	25						
11												
12	31	32	33	34	35	36						
13												

RC 1311


93 DEC 15 PM 4:58  
FOREST E. YOUNGBLOOD  
REGISTER OF DEEDS  
WAYNE COUNTY, MI

Signed by: [Signature]

Date: Nov 19 1993

Drafted By: Kenneth S. Wilkerson  
Surveyor's Michigan License No. 21584

Orchard, Hiltz & McCliment, Inc.  
34935 Schoolcraft Road \* Livonia, Michigan 48150 \* Phone: (313) 522-6711

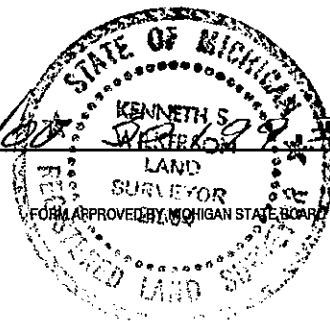

2R  
11KD