

SURVEY & REMONUMENTATION

RC 1429

L127794PA286

APR 25 1995

LAND CORNER RECORDATION CERTIFICATE

Filing Requirement of Act 74, Mich. P.A. 1970

A-03 Page 1

COMMISSION

For corners in

Wayne County	Located in:	Corner Code
	MONGUAGON	A-03
1. Public Land Survey	T 4 S R 11 E	
	T _____ R _____	
	T _____ R _____	
	T _____ R _____	
2. Property Controlling in Section	S _____ T _____ R _____	
	S _____ T _____ R _____	
3. Miscellaneous Property in Sec.	S _____ T _____ R _____	
	S _____ T _____ R _____	
4. Lot No. _____, Recorded Plat _____		
5. Private Claims _____		

Compliance with ACT 345, P.A. 1990

APPROVED ON: 12/9/94 WCO
WAYNE COUNTY REMONUMENTATION PEER GROUP COMMITTEE

Register of Deeds Stamp and File Number

I, Kenneth S. Wilkerson in a field survey on 11/08/1994 do hereby certify that under requirements of P.A. 74, Michigan P.A. of 1970, the corner points mentioned in lines 1 and 2 above were in conformance with regulations and rules therefore as required in the current manual of survey instructions of the United States Department of the Interior, Bureau of Land Management, or by a decree of a Court of Law and/or that the corner points mentioned in lines 3, 4 and 5 above were in conformance with the rules of the Michigan Board of Land Surveyors or by a Decree of a Court of Law, established, re-established, monumented, re-monumented, recovered, found as expressed below.

NOTE: Not more than 4 corners, all in the same town and range, may be recorded on this certificate.

	A	B	C	D	E	F	G	H	I	J	K	L	M
2	6	5	4	3	2	1							
3													
4	7	8	9	10	11	12							
5													
6	18	17	16	15	14	13							
7													
8	19	20	21	22	23	24							
9													
10	30	29	28	27	26	25							
11													
12	31	32	33	34	35	36							
13													

A. Description of original monument and accessories and/or subsequent restorations:

01/01/1817 G.L.O. ORIGINAL SET POST
L
12' SUGAR N20W 15 LINKS
8" LYNN EAST 30 LINKS

B. Description of corner evidence found and/or method applied in restoring or reestablishing corner:

FD. 1/2" I.R. IN MON. BOX (NO LID) IN ASPH. PAVE.

C. Description of monument for corner and accessories established to perpetuate locating the position of the corner:

11/08/1994 WILKERSON 21584 O.H.M. REMON
SET W.C.R. WASHIER AND CAP OVER CORNER.
7 FD. MHSD WIT. TAG N.W. SIDE P.P. S30E 68.31'
8 FD. W.C.R. TAG N. SIDE P.P. S70W 75.30'
9 FD. W.C.R. TAG S. SIDE P.P. N55W 79.44'
10 SET W.C.R. TAG S.E. SIDE P.P. N35E 51.41'


\$ 13.00 MISCELLANEOUS RECORDING
21 DEC 94 3:17 P.M. RECEIPT# 93A
RECORDED
FOREST E. YOUNGBLOOD, REGISTER OF DEEDS
WAYNE COUNTY, MI

We conclude that after careful study of the record documentation and field observations, that this corner is accepted as the best available evidence of the position of the original corner.

Signed by [Signature]
Drafted by Kenneth S. Wilkerson
Surveyor's Michigan License No. 21584

Date DEC 21 1994

Orchard, Hiltz and McCilment, Inc. 34935 Schoolcraft Road Livonia, MI 48150

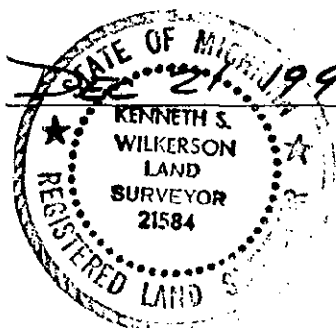

Z R
11 N. misc.