

SURVEY &
REMONUMENTATION

RC 1312

FEB 28 1994

LAND CORNER RECORDATION CERTIFICATE
Filing Requirement of Act 74, Mich. P.A. 1970

For corners in

COMMISSION

LI27042PA334

Wayne
County:
MONGUAGON TOWNSHIP #19

Located in: Corner Code #

1. Public Land Survey T 4 S R 11 E A-05
T _____ R _____
T _____ R _____
T _____ R _____

2. Property Controlling S _____
in Section S _____ T _____ R _____
S _____ T _____ R _____

3. Miscellaneous S _____
Property in Sec. S _____ T _____ R _____
S _____ T _____ R _____

4. Lot No. _____, Recorded Plat _____

5. Private Claims _____

Compliance with
ACT 345, P.A. 1990

APPROVED ON: 12-15-93 *DBJ*
WAYNE COUNTY REMONUMENTATION
PEER GROUP COMMITTEE

Register of Deeds Stamp & File Number

RC 1312

I, Kenneth S. Wilkerson in a field survey on October 28, 19 93,
do hereby certify that under requirements of P.A. 74, Michigan P.A. of 1970, the corner points mentioned
in lines 1 and 2 above were in conformance with regulations and rules therefore as required in the current
manual of survey instructions of the United States Department of the Interior, Bureau of Land Management
or by a decree of a Court of Law and/or that the corner points mentioned in lines 3, 4 and 5 above were in
conformance with the rules of the Michigan Board of Land Surveyors or by a Decree of a Court of Law;
established, re-established, monumented, re-monumented, recovered, found as expressed below:

NOTE: Not more than 4 corners, all in the same town and range, may be recorded on this certificate.

A. Description of original monument and accessories and/or subsequent restoration:

A-05 Set Post - GLO - NO GLO WITNESSES REMAIN
Iron - B of T
Fd. iron in mon box, L. 21944, P. 553 - 8/29/83

9 55 W 83.75 NAIL IN SE FACE GP GONE
S 45 W 40.45 R 40.42 M PK & TAG NW FACE U P
S 40 E 65.65 R & M PK & TAG NE FACE PP
S 40 E 71.00 TOP OF HYD - NOT FOUND

B. Description of corner evidence found and/or method applied in restoring or reestablishing corner:

A-05 Fd. mon in mon box per L 21944 P 553

C. Description of monument for corner and accessories established to perpetuate locating the position of the corner:

Set OHM - KSW 21584 cap on iron.

A-05 044 AZ 71.81 FD TAG IN NW FACE PP
116 AZ 70.79 TOP NUT ON HYD
129 AZ 65.65 FD TAG IN SW FACE PP
210 AZ 40.42 MDSH TAG IN SE FACE PP

The selected location is accepted as the best evidence of the position of the original corner.


	A	B	C	D	E	F	G	H	I	J	K	L	M
2	6	5	4	3	2	1							
3													
4	7	8	9	10	11	12							
5													
6	18	17	16	15	14	13							
7													
8	19	20	21	22	23	24							
9													
10	30	29	28	27	26	25							
11													
12	31	32	33	34	35	36							
13													

Signed by:

Kenneth S. Wilkerson

Date:

12-15-93

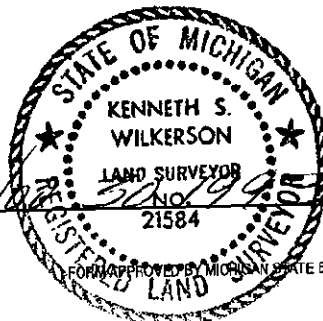

Drafted By: Kenneth S. Wilkerson
Surveyor's Michigan License No. 21584

Orchard, Hiltz & McCliment, Inc.
34935 Schoolcraft Road * Livonia, Michigan 48150 * Phone: (313) 522-6711

93 DEC 15 PM 1:59
FOREST E. YOUNGBLOOD
REGISTER OF DEEDS
MICHIGAN, MI

*2R
11KJ*