

**SURVEY &
REMONUMENTATION**

RC 1626

LI27802PA195

APR 25 1995

LAND CORNER RECORDATION CERTIFICATE

COMMISSION

Filing Requirement of Act 74, Mich. P.A. 1970

A-06 Page 1

For corners in	Wayne	Located in:	Corner Code
	County	Monguagon Twp.	
1. Public Land Survey		T 4 S R 11 E	A-06
		T _____ R _____	_____
		T _____ R _____	_____
		T _____ R _____	_____
2. Property Controlling in Section	S _____	T _____ R _____	_____
	S _____	T _____ R _____	_____
3. Miscellaneous Property in Sec.	S _____	T _____ R _____	_____
	S _____	T _____ R _____	_____
4. Lot No. _____, Recorded Plat _____			
5. Private Claims _____			

Compliance with
ACT 345, P.A. 1990
APPROVED ON: 12-9-94 *DBJ*
WAYNE COUNTY REMONUMENTATION
PEER GROUP COMMITTEE

Register of Deeds Stamp and File Number

RC 1626

I, Kenneth S. Wilkerson in a field survey on 11/30/1994
do hereby certify that under requirements of P.A. 74, Michigan P.A. of 1970, the corner points mentioned in lines 1 and 2 above were in conformance with regulations and rules therefore as required in the current manual of survey instructions of the United States Department of the Interior, Bureau of Land Management, or by a decree of a Court of Law and/or that the corner points mentioned in lines 3, 4 and 5 above were in conformance with the rules of the Michigan Board of Land Surveyors or by a Decree of a Court of Law, established, re-established, monumented, re-monumented, recovered, found as expressed below.

NOTE: Not more than 4 corners, all in the same town and range, may be recorded on this certificate.

	A	B	C	D	E	F	G	H	I	J	K	L	I
2	6	5	4	3	2	1							
3													
4	7	8	9	10	11	12							
5													
6	18	17	16	15	14	13							
7													
8	19	20	21	22	23	24							
9													
10	30	29	28	27	26	25							
11													
12	31	32	33	34	35	36							
13													

A. Description of original monument and accessories and/or subsequent restorations:
01/01/1816 G.L.O. Set post
NO WITNESSES REMAIN

(Witnesses Continued on Back ...)

B. Description of corner evidence found and/or method applied in restoring or reestablishing corner:
Fd. 1/2" iron in mon. box per L 22834, P 744


C. Description of monument for corner and accessories established to perpetuate locating the position of the corner:
11/30/1994 Wilkerson 21584 O.H.M. Remon.
10 085 AZ 52.39 FD PK IN S FACE PP
11 257 AZ 14.68 FD X IN NE COR CB
12 305 AZ 21.31 FD PK IN NE FACE PP
13 244 AZ 53.17 SW COR OF CB

\$ 16.00 MISCELLANEOUS RECORDING
28 DEC 94 1:37 P.M. RECEIPT# 511
RECORDED
FOREST E. YOUNGBLOOD, REGISTER OF DEEDS
WAYNE COUNTY, MI

We conclude that after careful study of the record documentation and field observations, that this corner is accepted as the best available evidence of the position of the original corner.

Signed by *Kenneth S. Wilkerson*
Drafted by Kenneth S. Wilkerson
Surveyor's Michigan License No. 21584
Orchard, Hiltz and McCliment, Inc. 34935 Schoolcraft Road Livonia, MI 48150

Date DEC 28 1994

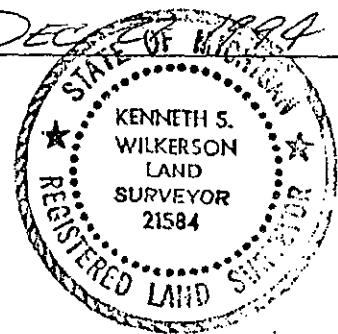

ZF
14
MISC

(Continued) Description of original monument and accessories and/or subsequent restorations:

01/01/1930	B of T	Set spike in pav't
1	NE 64.65 2" ELM	
2	E 35.43 NAIL IN S SIDE 8" ELM	
3	SE 52.64 NAIL IN NE SIDE ED P	
4	SW 72.70 3" ELM	
5	NW 44.92 NAIL IN SW FACE POLE	
10/21/1977	L 19957, P 812	Fd. 3/4" rod in mon. box
6	E 7.90 W EDGE OF PAV'T	
7	S 70 W 15.24 SE CORNER CB	
8	N 70 W 21.45 PK NAIL NE SIDE TRAFFIC LT. POLE	
05/06/1986	L 22834, P 744	Fd. 3/4" rod in mon. box
9	N 30 E 100.51 PK IN SE FACE PP - NOT FOUND	
10	N 83 E 52.72 R 52.38 M PK IN S FACE PP	
11	S 76 W 14.64 M X ON NE COR CB	
12	N 54 W 21.42 R 21.31 M PK IN NE FACE GP	