

RC 1314

FEB 28 1994

LAND CORNER RECORDATION CERTIFICATE
Filing Requirement of Act 74, Mich. P.A. 1970

LI27042PA336

For corners in **COMMISSION**

Wayne
County:
MONGUAGON TOWNSHIP #19

	Located in:	Corner Code #
1. Public Land Survey	T <u>4 S</u> R <u>11 E</u>	B-01
	T _____ R _____	_____
	T _____ R _____	_____
	T _____ R _____	_____
2. Property Controlling in Section	S _____ T _____	_____
	S _____ T _____	_____
3. Miscellaneous Property in Sec.	S _____ T _____	_____
	S _____ T _____	_____

Compliance with
ACT 345, P.A. 1990

APPROVED ON: 12-15-93 *JGJ*

**WAYNE COUNTY REMONUMENTATION
PEER GROUP COMMITTEE**

Register of Deeds Stamp & File Number

4. Lot No. _____, Recorded Plat _____
5. Private Claims _____

I, Kenneth S. Wilkerson, in a field survey on October 28, 19 93, do hereby certify that under requirements of P.A. 74, Michigan P.A. of 1970, the corner points mentioned in lines 1 and 2 above were in conformance with regulations and rules therefore as required in the current manual of survey instructions of the United States Department of the Interior, Bureau of Land Management or by a decree of a Court of Law and/or that the corner points mentioned in lines 3, 4 and 5 above were in conformance with the rules of the Michigan Board of Land Surveyors or by a Decree of a Court of Law; established, re-established, monumented, re-monumented, recovered, found as expressed below:

NOTE: Not more than 4 corners, all in the same town and range, may be recorded on this certificate.

A. Description of original monument and accessories and/or subsequent restoration:

B-01 Set Post - GLO - NO GLO WITNESSES REMAIN
Iron - B of T
Fd. 1/2" iron in mon box, L. 18787, P. 706 - 4/01/74

N 60 E 61.34 R 61.40 M PP
S 45 E 71.85 R 71.62 M PP
N 40 W 66.96 67.11 m PP

B. Description of corner evidence found and/or method applied in restoring or reestablishing corner:

B-01 Fd. 1/2" iron in mon box per L 18787, P 706

C. Description of monument for corner and accessories established to perpetuate locating the position of the corner:

Set Wayne County remonumentation washer and OHM - KSW 21584 cap on iron.

B-01 042 AZ 51.17 TOP NUT ON HYD
064 AZ 61.40 OHM TAG SE FACE PP
127 AZ 71.62 OHM TAG NE FACE PP
323 AZ 67.11 OHM TAG SW FACE PP

The selected location is accepted as the best evidence of the position of the original corner.


	A	B	C	D	E	F	G	H	I	J	K	L	M
2	6	5	4	3	2	1							
3													
4	7	8	9	10	11	12							
5													
6	18	17	16	15	14	13							
7													
8	19	20	21	22	23	24							
9													
10	30	29	28	27	26	25							
11													
12	31	32	33	34	35	36							
13													

RC 1314

9:15 PM 12-15-93
FOREST E. YOUNGBLOOD
REGISTER OF DEEDS
WAYNE COUNTY, MI

Signed by *Kenneth S. Wilkerson*

Date: _____

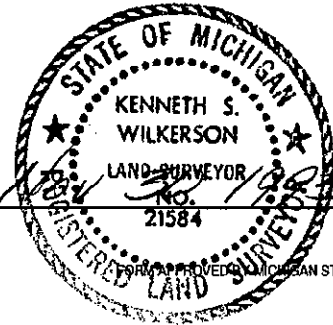

Drafted By: Kenneth S. Wilkerson
Surveyor's Michigan License No. 21584

Orchard, Hiltz & McCliment, Inc.
34935 Schoolcraft Road * Livonia, Michigan 48150 * Phone: (313) 522-6711

FORM APPROVED BY MICHIGAN STATE BOARD OF LAND SURVEYORS, JAN. 28, 1971
REVISED MAY 14, 1975
REVISED JAN., 1983

21584