

SURVEY & REMONUMENTATION

APR 25 1995

COMMISSION

RC 1627

LI27802PA197

LAND CORNER RECORDATION CERTIFICATE

Filing Requirement of Act 74, Mich. P.A. 1970

B-03 Page 1

For corners in

Wayne County	Located in: Monguagon Twp.	Corner Code
1. Public Land Survey	T <u>4</u> S R <u>11</u> E	B-03
	T _____ R _____	_____
	T _____ R _____	_____
	T _____ R _____	_____
2. Property Controlling in Section	S _____ T _____ R _____	_____
	S _____ T _____ R _____	_____
3. Miscellaneous Property in Sec.	S _____ T _____ R _____	_____
	S _____ T _____ R _____	_____
4. Lot No. _____, Recorded Plat _____		
5. Private Claims _____		

Compliance with ACT 345, P.A. 1990
 APPROVED ON: 12-9-94
 WAYNE COUNTY REMONUMENTATION PEER GROUP COMMITTEE

Register of Deeds Stamp and File Number

I, Kenneth S. Wilkerson in a field survey on 11/30/1994 do hereby certify that under requirements of P.A. 74, Michigan P.A. of 1970, the corner points mentioned in lines 1 and 2 above were in conformance with regulations and rules therefore as required in the current manual of survey instructions of the United States Department of the Interior, Bureau of Land Management, or by a decree of a Court of Law and/or that the corner points mentioned in lines 3, 4 and 5 above were in conformance with the rules of the Michigan Board of Land Surveyors or by a Decree of a Court of Law, established, re-established, monumented, re-monumented, recovered, found as expressed below.

NOTE: Not more than 4 corners, all in the same town and range, may be recorded on this certificate.

	A	B	C	D	E	F	G	H	I	J	K	L	M
2	6	5	4	3	2	1							
3	7	8	9	10	11	12							
4													
5													
6	18	17	16	15	14	13							
7													
8	19	20	21	22	23	24							
9													
10	30	29	28	27	26	25							
11													
12	31	32	33	34	35	36							
13													

A. Description of original monument and accessories and/or subsequent restorations:
 01/01/1816 G.L.O. Set post
 NO WITNESSES REMAIN
 01/01/1930 B of T Iron
 1 NE 78.40 NAIL IN SE SIDE 20" ELM

(Witnesses Continued on Back ...)

B. Description of corner evidence found and/or method applied in restoring or reestablishing corner:
 Fd. 1/2" iron in mon. box per L 18792, P 445

C. Description of monument for corner and accessories established to perpetuate locating the position of the corner:
 11/30/1994 Wilkerson 21584 O.H.M.

- SET W.C.R. WASHER AND CAP ON CORNER
- 10 054 AZ 46.87 FD WCRC TAG IN SE FACE PP
- 11 148 AZ OHM TAG IN NE FACE PP
- 12 228 AZ 71.85 OHM TAG IN SW FACE PP
- 13 289 AZ 76.10 FD WCRC TAG IN SE FACE PP


\$ 16.00 MISCELLANEOUS RECORDING
 28 DEC 94 1137 P.M. RECEIPT# 51B
 RECORDED
 FOREST E. YOUNGBLOOD, REGISTER OF DEEDS
 WAYNE COUNTY, MI

We conclude that after careful study of the record documentation and field observations, that this corner is accepted as the best available evidence of the position of the original corner.

Signed by [Signature]
 Drafted by Kenneth S. Wilkerson
 Surveyor's Michigan License No. 21584

Date Dec 94

Orchard, Hiltz and McCliment, Inc. 34935 Schoolcraft Road Livonia, MI 48150

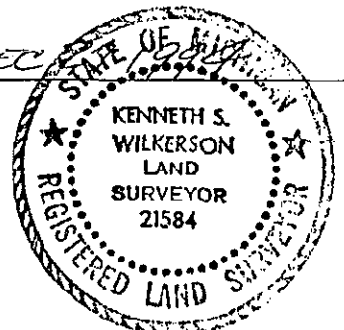

2R
 14D
 MISC

(Continued) Description of original monument and accessories and/or subsequent restorations:

01/01/1930 B of T Iron
 2 SW 53.53 NAIL IN SE SIDE 4" ASH
 3 NW 89.95 NAIL IN NE SIDE 24" ELM
 4 NW 48.48 NAIL IN NE SIDE 26" ELM

04/02/1973 W.C.R.C. Mon.
 5 S 24 23 10 W 58.00 PK IN U P
 6 S 53 51 W 44.62 PK IN U P
 7 N 33 42 10 W 44.29 PK IN U P
 8 N 62 21 10 E 53.00 PK IN U P
 9 S 70 23 E 75.58 PK IN U P

04/20/1974 L 18792, P 445 Iron in mon. box
 5 N 30 E 58.04 PK IN NW FACE PP
 6 N 60 E 44.60 PK IN SE FACE PP
 7 S 35 E 44.30 PK IN NE FACE PP
 8 S 60 W 52.98 PK IN SE FACE PP
 9 N 70 W 75.53 PK IN S FACE PP