

RECORDED
 FEB 28 1994
 COMMISSION

RC 1316

LAND CORNER RECORDATION CERTIFICATE
 Filing Requirement of Act 74, Mich. P.A. 1970

LI27042PA338

For corners in

Wayne
 County:
 MONGUAGON TOWNSHIP #19

Located in: Corner Code #

1. Public Land Survey	T 4 S	R 11 E	B-05
	T	R	
	T	R	
	T	R	
	T	R	
2. Property Controlling in Section	S	T	R
	S	T	R
3. Miscellaneous Property in Sec.	S	T	R
	S	T	R

4. Lot No. _____, Recorded Plat _____

5. Private Claims _____

Compliance with
 ACT 345, P.A. 1990
 APPROVED ON: 12-15-93 DJJ
 WAYNE COUNTY REMONUMENTATION
 PEER GROUP COMMITTEE

Register of Deeds Stamp & File Number

I, Kenneth S. Wilkerson, in a field survey on October 28, 1993, do hereby certify that under requirements of P.A. 74, Michigan P.A. of 1970, the corner points mentioned in lines 1 and 2 above were in conformance with regulations and rules therefore as required in the current manual of survey instructions of the United States Department of the Interior, Bureau of Land Management or by a decree of a Court of Law and/or that the corner points mentioned in lines 3, 4 and 5 above were in conformance with the rules of the Michigan Board of Land Surveyors or by a Decree of a Court of Law; established, re-established, monumented, re-monumented, recovered, found as expressed below:

	A	B	C	D	E	F	G	H	I	J	K	L	M
2	6	5	4	3	2	1							
3													
4	7	8	9	10	11	12							
5													
6	18	17	16	15	14	13							
7													
8	19	20	21	22	23	24							
9													
10	30	29	28	27	26	25							
11													
12	31	32	33	34	35	36							
13													

NOTE: Not more than 4 corners, all in the same town and range, may be recorded on this certificate.

A. Description of original monument and accessories and/or subsequent restoration:

B-05 Set Post - GLO - NO GLO WITNESSES REMAIN
 Iron - B of T
 Fd. iron rod in mon box - agrees with previous surveys
 L 21944, P. 553 (8/29/83)

N 45 W 57.75 R & M LPG PIPELINE MARKER
 S 60 E 67.75 PK & TAG NE FACE PP - GONE
 S 10 W 35.05 FENCE GATE POST - GONE
 S 30 W 39.50 FENCE GATE POST - GONE

B. Description of corner evidence found and/or method applied in restoring or reestablishing corner:

B-06 Fd. conc. mon in mon box per L 21944, P 553

C. Description of monument for corner and accessories established to perpetuate locating the position of the corner:


Set Wayne County remonumentation washer and OHM - KSW 21584 cap on iron.

B-05 000 AZ 39.41 N B/CURB
 190 AZ 67.80 WCRC TAG IN NE FACE PP
 180 AZ 33.92 N FACE RETAINING WALL
 258 AZ 122.11 WCRC TAG IN SE FACE PP
 302 AZ 68.85 SE COR CB

The selected location is accepted as the best evidence of the position of the original corner.

Signed by Kenneth S. Wilkerson

Date: _____

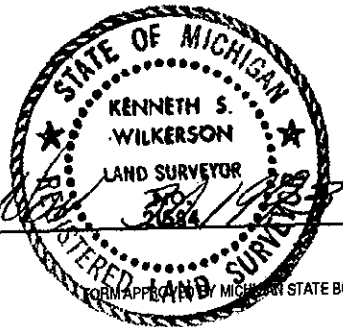

Drafted By: Kenneth S. Wilkerson
 Surveyor's Michigan License No. 21584

Orchard, Hiltz & McCliment, Inc.
 34935 Schoolcraft Road * Livonia, Michigan 48150 * Phone: (313) 522-6711

FORESTER YOUNG BROS
 REGISTERED DEEDS
 MICHIGAN
 157 MI

93 DEC 15 PM 4:59

2R
 11K