

**SURVEY &
REMONUMENTATION**

RC 1430

L127794PA287

APR 25 1995

LAND CORNER RECORDATION CERTIFICATE

COMMISSION

Filing Requirement of Act 74, Mich. P.A. 1970

C-01 Page 1

For corners in

Wayne County	Located In: MONGUAGON	Corner Code C-01
1. Public Land Survey	T 4 S R 11 E T _____ R _____ T _____ R _____ T _____ R _____	_____
2. Property Controlling in Section	S _____ T _____ R _____ S _____ T _____ R _____	_____
3. Miscellaneous Property in Sec.	S _____ T _____ R _____ S _____ T _____ R _____	_____
4. Lot No. _____, Recorded Plat _____		
5. Private Claims _____		

Compliance with
ACT 345, P.A. 1990

APPROVED ON: 12/9/94 TCA
WAYNE COUNTY REMONUMENTATION
PEER GROUP COMMITTEE

Register of Deeds Stamp and File Number

I, Kenneth S. Wilkerson in a field survey on 11/29/1994
do hereby certify that under requirements of P.A. 74, Michigan P.A. of 1970, the corner points mentioned in lines 1 and 2 above were in conformance with regulations and rules therefore as required in the current manual of survey instructions of the United States Department of the Interior, Bureau of Land Management, or by a decree of a Court of Law and/or that the corner points mentioned in lines 3, 4 and 5 above were in conformance with the rules of the Michigan Board of Land Surveyors or by a Decree of a Court of Law, established, re-established, monumented, re-monumented, recovered, found as expressed below.

NOTE: Not more than 4 corners, all in the same town and range, may be recorded on this certificate.

	A	B	C	D	E	F	G	H	I	J	K	L	M
2	8	5	4	3	2	1							
3													
4	7	8	9	10	11	12							
5													
6	18	17	16	15	14	13							
7													
8	19	20	21	22	23	24							
9													
10	30	29	28	27	26	25							
11													
12	31	32	33	34	35	36							
13													

A. Description of original monument and accessories and/or subsequent restorations:

01/01/1817

G.L.O.

SET POST

W. ASH 12 N60. E 30
B. ASH 12 N 60 E 30

B. Description of corner evidence found and/or method applied in restoring or reestablishing corner:

Found P.K. nail in asphalt pavement. Dug 1' deep found 1/2" iron in mon. box.

C. Description of monument for corner and accessories established to perpetuate locating the position of the corner:

11/29/1994 Wilkerson 21584 O.H.M. Remon

SET WCR WASHER AND CAP OVER CORNER


- 4 FD. P.K. NAIL IN W. SIDE P.P. SET WCR TAG N 20 W 27.38'
- 5 CL HYD. S 50 W 58.75'
- 6 FD. P.K. W/TAG IN NW SIDE P.P. SET WCR TAG S 40 W 56.15'
- 7 FD. O.H.M. T.P. IRON N 43.82'
- 8 FD. O.H.M. T.P. IRON S 45.32'

\$ 13.00 MISCELLANEOUS RECORDING
21 DEC 94 3:17 P.M. RECEIPT# 93A
RECORDED
FOREST E. YOUNGBLOOD, REGISTER OF DEEDS
WAYNE COUNTY, MI

We conclude that after careful study of the record documentation and field observations, that this corner is accepted as the best available evidence of the position of the original corner.

Signed by [Signature] Date DEC 21 1994
Drafted by Kenneth S. Wilkerson
Surveyor's Michigan License No. 21584

Orchard, Hiltz and McCliment, Inc. 34935 Schoolcraft Road Livonia, MI 48150

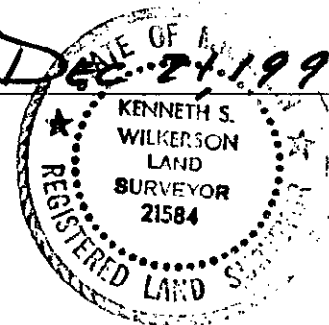

ZR
11 N - MISC