

LAND CORNER RECORDATION CERTIFICATE

Filing Requirement of Act 74, Mich. P.A. 1970

For corners in		Located in:	Corner Code
<u>Wayne</u>		<u>Riverview</u>	
County			
1. Public Land Survey		T <u>4</u> S R <u>11</u> E	<u>C-03</u>
		T _____ R _____	_____
		T _____ R _____	_____
		T _____ R _____	_____
2. Property Controlling in Section	S _____	T _____ R _____	_____
	S _____	T _____ R _____	_____
3. Miscellaneous Property in Sec.	S _____	T _____ R _____	_____
	S _____	T _____ R _____	_____
4. Lot No. _____, Recorded Plat _____			
5. Private Claims _____			

LI 29356 PA 901

Compliance with ACT 345, P.A. 1990

APPROVED ON: 12-14-96
WAYNE COUNTY REMONUMENTATION PEER GROUP COMMITTEE

Register of Deeds Stamp and File Number

I, Kenneth S. Wilkerson in a field survey on 12/12/1996 do hereby certify that under requirements of P.A. 74, Michigan P.A. of 1970, the corner points mentioned in lines 1 and 2 above were in conformance with regulations and rules therefore as required in the current manual of survey instructions of the United States Department of the Interior, Bureau of Land Management, or by a decree of a Court of Law and/or that the corner points mentioned in lines 3, 4 and 5 above were in conformance with the rules of the Michigan Board of Land Surveyors or by a Decree of a Court of Law, established, re-established, monumented, re-monumented, recovered, found as expressed below.

NOTE: Not more than 4 corners, all in the same town and range, may be recorded on this certificate.

A	B	C	D	E	F	G	H	I	J	K	L	M
2	6	5	4	3	2	1						
3		●										
4	7	8	9	10	11	12						
5												
6	18	17	16	15	14	13						
7												
8	19	20	21	22	23	24						
9												
10	30	29	28	27	26	25						
11												
12	31	32	33	34	35	36						
13												

A. Description of original monument and accessories and/or subsequent restorations:

05/05/1816 G.L.O. Set post
 Thorn tree N23E 0.45 chains
 12" apple tree SSE 0.76 chains

(Witnesses Continued on Back ...)

B. Description of corner evidence found and/or method applied in restoring or reestablishing corner:

Set 1/2" iron rod with W.C.R. cap in CSX Rail Road yard, Measured east from B-03 on line 2645.12 (M,R) per 1930's BT measurements, split between Fd. irons N & S along Sibley to establish direction.

C. Description of monument for corner and accessories established to perpetuate locating the position of the corner:


12/12/1996 Wilkerson 21584 OHM remon
 5 N30E 8.62' NE corner of sanitary chamber
 6 S65E 18.75' SW corner of sanitary chamber
 7 S60W 79.81' set nail with remon tag in N face of 15" Elm.
 8 S48W 91.85' set nail with remon tag in N face of 12" Ash

\$ 4.00 REMONUMENTATION
 30 DEC 96 1:38 P.M. RECEIPT# 44B
 RECORDED
 FOREST E. YOUNGBLOOD, REGISTER OF DEEDS
 WAYNE COUNTY, MI
 \$ 4.00 REMONUMENTATION

We conclude that after careful study of the record documentation and field observations, that this corner is accepted as a careful and faithful perpetuation of the position of the original corner.

Signed by [Signature] Date Dec 26 1996
 Drafted by Kenneth S. Wilkerson
 Surveyor's Michigan License No. 21584

Orchard, Hiltz and McCliment, Inc. 34935 Schoolcraft Road Livonia, MI 48150

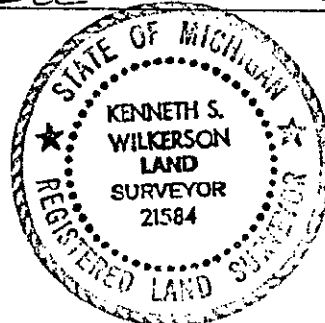

4K
10L
DB

A. (Continued) Description of original monument and accessories and/or subsequent restorations:

05/31/1926 Brown Mason L. Brown plat not called out
no witnesses

08/07/1932 W.C.B.T. Fd. stone

- 1 26" Elm NW 32.93' (gone)
- 2 8" Locust North 30.98' (gone)
- 3 Ed. pole NE 46.95' (gone)
- 4 Light pole SW 122.95 (gone)
- 4 Tel. pole South 50.07' (gone)

LI29866PA902

07/29/1971 Dely McMahon Engineering Company Certificate no mention

no witnesses

02/20/1973 Arthurs sketch no mention
no witnesses