

SURVEY & REMONUMENTATION

RC 1431

L127794PA288

APR 25 1995

LAND CORNER RECORDATION CERTIFICATE

COMMISSION

Filing Requirement of Act 74, Mich. P.A. 1970

D-01 Page 1

For corners in

Wayne County	Located In:	Corner Code
	MONGUAGON	D-01
1. Public Land Survey	T <u>4</u> S R <u>11</u> E	_____
	T _____ R _____	_____
	T _____ R _____	_____
	T _____ R _____	_____
2. Property Controlling In Section	S _____ T _____ R _____	_____
	S _____ T _____ R _____	_____
3. Miscellaneous Property In Sec.	S _____ T _____ R _____	_____
	S _____ T _____ R _____	_____
4. Lot No. _____, Recorded Plat _____		
5. Private Claims _____		

Compliance with ACT 345, P.A. 1990
 APPROVED ON: 12/19/94 TCR
 WAYNE COUNTY REMONUMENTATION PEER GROUP COMMITTEE

Register of Deeds Stamp and File Number

I, Kenneth S. Wilkerson in a field survey on 11/29/1994 do hereby certify that under requirements of P.A. 74, Michigan P.A. of 1970, the corner points mentioned in lines 1 and 2 above were in conformance with regulations and rules therefore as required in the current manual of survey instructions of the United States Department of the Interior, Bureau of Land Management, or by a decree of a Court of Law and/or that the corner points mentioned in lines 3, 4 and 5 above were in conformance with the rules of the Michigan Board of Land Surveyors or by a Decree of a Court of Law, established, re-established, monumented, re-monumented, recovered, found as expressed below.

NOTE: Not more than 4 corners, all in the same town and range, may be recorded on this certificate.

	A	B	C	D	E	F	G	H	I	J	K	L	M
2	8		5		4		3		2		1		
3													
4	7		8		9		10		11		12		
5													
6	18		17		16		15		14		13		
7													
8	19		20		21		22		23		24		
9													
10	30		29		28		27		26		25		
11													
12	31		32		33		34		35		36		
13													

A. Description of original monument and accessories and/or subsequent restorations:

01/01/1817 G.L.O. SET POST
 P.P 9 S 78 E. 92 LINKS
 01/01/1930 WAYNE CO. IRON
 B/T
 1 L.P. NW 27.94'

(Witnesses Continued on Back ...)

B. Description of corner evidence found and/or method applied in restoring or reestablishing corner:

1" iron pipe in mon. box in asph. pvmt at int. of CL's of W. Jefferson and Pennsylvania

C. Description of monument for corner and accessories established to perpetuate locating the position of the corner:


11/29/1994 Wilkerson 21584 O.H.M. Remon
 SET WCR WASHER AND CAP OVER CORNER
 1 CL HYD. N 10 W 82.33'
 2 CL HYD. S 75 W 99.89'
 3 FD. O.H.M. K.S.W. TAG SW SIDE P.P. SET WCR TAG S 25 E 64.75'
 5 FD. PK. W/TAG SET WCR TAG ON NW SIDE P.P. S 70 W 91.82'
 6 S.E. BOLT ON LT. P. N 50 W 55.72'

\$ 16.00 MISCELLANEOUS RECORDING
 21 DEC 94 3:18 P.M. RECEIPT# 93A
 RECORDED
 FOREST E. YOUNGBLOOD, REGISTER OF DEEDS
 WAYNE COUNTY, MI

We conclude that after careful study of the record documentation and field observations, that this corner is accepted as the best available evidence of the position of the original corner.

Signed by [Signature]
 Drafted by Kenneth S. Wilkerson
 Surveyor's Michigan License No. 21584

Date DEC 21 1994

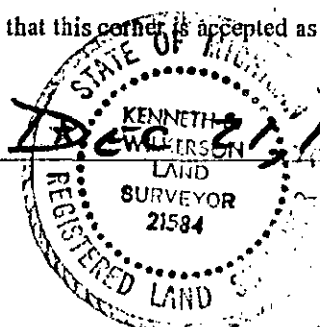

Orchard, Hiltz and McCliment, Inc. 34935 Schoolcraft Road Livonia, MI 48150

Z R
 14 N - MISC.

A (Continued) Description of original monument and accessories and/or subsequent restorations:

01/01/1817	G.L.O.	SET POST
W.O 12 N 20 W 3.39 LINKS		
01/01/1930	WAYNE CO. B/T	IRON
2 HYD. NW 57.66'		
3 X ON WALK SE 56.51'		
4 RD SIGN SW 82.10'		