

LIBER 28477 PAGE 224

**LAND CORNER RECORDATION CERTIFICATE**  
 Filing Requirement of Act 74, Mich. P.A. 1970

PC-555SW Page 1

For corners in  
Wayne  
 County

Located in:  
 MONGUAGON

OTHER  
 Corner Code  
 GROSSE ILE  
 PC-555SW

SEQUENCE #2  
 LIBER 28647 PAGE 709

Compliance with  
 ACT 345, P.A. 1990

APPROVED ON: 11-30-95 DJJ  
 WAYNE COUNTY REMONUMENTATION  
 BOARD GROUP COMMITTEE

1. Public Land Survey T 4 S R 11 E  
 T \_\_\_ R \_\_\_  
 T \_\_\_ R \_\_\_  
 T \_\_\_ R \_\_\_
2. Property Controlling S \_\_\_ T \_\_\_ R \_\_\_  
 In Section S \_\_\_ T \_\_\_ R \_\_\_
3. Miscellaneous S \_\_\_ T \_\_\_ R \_\_\_  
 Property in Sec. S \_\_\_ T \_\_\_ R \_\_\_
4. Lot No. \_\_\_\_\_, Recorded Plat \_\_\_\_\_
5. Private Claims \_\_\_\_\_

#004  
 Seq. #2  
 Pg 709

Register of Deeds Stamp and File Number

|    | A  | B  | C  | D  | E  | F  | G | H | I | J | K | L | M |
|----|----|----|----|----|----|----|---|---|---|---|---|---|---|
| 2  | 6  | 5  | 4  | 3  | 2  | 1  |   |   |   |   |   |   |   |
| 3  |    |    |    |    |    |    |   |   |   |   |   |   |   |
| 4  | 7  | 8  | 9  | 10 | 11 | 12 |   |   |   |   |   |   |   |
| 5  |    |    |    |    |    |    |   |   |   |   |   |   |   |
| 6  | 18 | 17 | 16 | 15 | 14 | 13 |   |   |   |   |   |   |   |
| 7  |    |    |    |    |    |    |   |   |   |   |   |   |   |
| 8  | 19 | 20 | 21 | 22 | 23 | 24 |   |   |   |   |   |   |   |
| 9  |    |    |    |    |    |    |   |   |   |   |   |   |   |
| 10 | 30 | 29 | 28 | 27 | 26 | 25 |   |   |   |   |   |   |   |
| 11 |    |    |    |    |    |    |   |   |   |   |   |   |   |
| 12 | 31 | 32 | 33 | 34 | 35 | 36 |   |   |   |   |   |   |   |
| 13 |    |    |    |    |    |    |   |   |   |   |   |   |   |

I, Kenneth S. Wilkerson in a field survey on 12/04/1995  
 do hereby certify that under requirements of P.A. 74, Michigan P.A. of 1970, the corner points  
 mentioned in lines 1 and 2 above were in conformance with regulations and rules therefore as  
 required in the current manual of survey Instructions of the United States Department of the  
 Interior, Bureau of Land Management, or by a decree of a Court of Law and/or that the corner  
 points mentioned in lines 3, 4 and 5 above were in conformance with the rules of the Michigan  
 Board of Land Surveyors or by a Decree of a Court of Law, established, re-established,  
 monumented, re-monumented, recovered, found as expressed below.

NOTE: Not more than 4 corners, all in the same town and range, may be  
 recorded on this certificate.

A. Description of original monument and accessories and/or subsequent restorations:

01/01/1805 GREELEY  
 ON THIS DATE  
 NO WITNESSES

SET POST

(Witnesses Continued on Back ...)

B. Description of corner evidence found and/or method applied in restoring or reestablishing corner:

REESTABLISHED SW CORNER OF PRIVATE CLAIM 555 BY SUPERVISORS PLAT NO. 43 L.64,  
 P.99 & GROSSE ILE MANOR L.58 P.89

C. Description of monument for corner and accessories established to perpetuate locating the position of the corner:

12/04/1995 WILKERSON 21485 O.H.M. REMON

SET 1/2" IRON ROD IN GRASSY AREA WITH W.C.R. CAP  
 CORNER FALLS INTO THE DETROIT RIVER

- 1 SET P.K. NAIL IN JOINT CO CONC. RETAINING WALL N55W 10.45'
- 2 P.K. NAIL IN N. STEM OF TWIN 6" APPLE S20E 13.98'
- 3 N.E. COR OF BRIDGE S21W 32.64'
- 4 P.K. SET IN WALK N. SIDE OF BRIDGE S35W 43.83'

\$ 10.00 DEED  
 21 DEC 95 9:21 A.M. RECEIPT# 58  
 RECORDED  
 FOREST E. YOUNGBLOOD, REGISTER OF DEEDS  
 WAYNE COUNTY, MI  
 \$ 4.00 REMONUMENTATION

95273192838-7 AM:27  
 96065624


We conclude that after careful study of the record documentation and field observations, that this corner is accepted as  
 the best available evidence of the position of the original corner.

Signed by [Signature]  
 Drafted by Kenneth S. Wilkerson  
 Surveyor's Michigan License No. 21584

Date DEC 13 1995

Orchard, Hiltz and McCliment, Inc. 34935 Schoolcraft Road Livonia, MI 48150

RECORDED TO ADD PER GROUP DATE

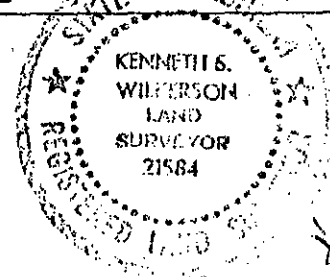

RE-RECORD

A. (Continued) Description of original monument and accessories and/or subsequent restorations:

01/01/1995

- 1 GROSSE ILE MANOR L.58 P.89
- 2 SUPERVISORS GROSSE ILE NO. 43 L.64, P.99.
- 3 SUPERVISORS GROSSE ILE NO. 38

LIBER 28477 PAGE 225

LIBER 28647 PAGE 710

FILED DO NOT MAIL

RE-RECORD