


NOTE: This survey was based on the assumption that the section and quarter-section corners, which were found in place, were perpetuated from the United States Land Survey of 1817. Lost corners were established by proportional measurements from the known corners. Fence lines and marked boundaries long acquiesced were recognized as property

lines. The following survey points ①, ②, ③, ④, ⑤, ⑥, ⑦, ⑧,

⑨, ⑩, ⑪, ⑫, ⑬, ⑭, ⑮, ⑯, ⑰, ⑱, ⑲, ⑳, ㉑, ㉒,

㉓, ㉔, ㉕ and ㉖ delineate the property line and are monumented with

4" iron pipe, filled with concrete and capped with a standard Michigan section corner brass cap on which the location data is stamped.

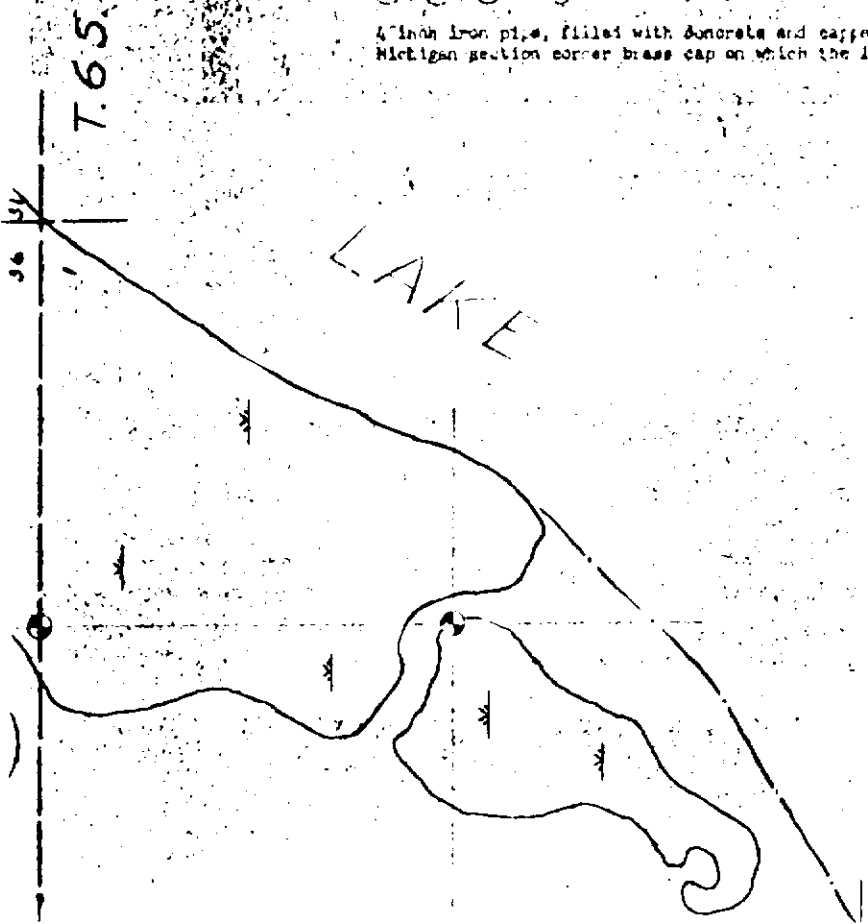

WITNESSES

- ① 1/4 Corner 26, 27, 28, 29  
1 1/2" Iron Pipe 5 ft. centerline Roberts & Labo lds.  
S. 67° 13' W., 19.18 ft. to horiz. spike in 2" fence post  
S. 15° 30' W., 19.29 ft. to 4" pine road sign  
S. 67° 13' W., 15.66 ft. to steel fence post 1 in. high  
E. 29° 30' E., 44.35 ft. to center of 10 in. oak alder tree
- ② 1/4 Corner lot. 24 & 25  
1 1/2" 6 in. gray rock, trace of broken glass  
Set brass S. C. Mon. on 1 in. iron pipe, 4 in. below rd. surface  
N. 21° W., 34.34 ft. to 2" pipe road sign  
N. 47° E., 25.75 ft. to 4" gate post, 2" iron pipe  
N. 82° 20' E., 25.29 ft. to a S. gate post, 3" iron pipe
- ③ 1/4 Corner 2, 3, 24, 25  
Fd. old square what stake in rotted cast iron  
Set brass S. C. Mon. on 1 1/2" iron pipe, 5 ft. below rd. surface  
S. 45° 30' E., 20.31 ft. to a horiz. spike in 1 1/2" dia  
S. 50° 3' W., 24.36 ft. to 2 in. pipe, road sign  
N. 68° W., 83.13 ft. to horiz. spike in 6" W. dia 3/4 in. dia  
rest on centerline collect bin, 110.3 ft. to E. edge conc. bridge deck
- ④ 1/4 corner lot. 2 & 2  
Fd. 5/8 d. spike 1 1/2' west of rd. centerline 1 in line with fence west.  
Used by local surveyors for property surveys  
Set 3/4" x 30" iron pipe & wood sta. marker  
N. 42° E., 36.62 ft. to steel fence post  
N. 42° 30' W., 14.74 ft. to horiz. spike in 2 in. fence post  
N. 56° 45' E., 87.67 ft. to S. W. cor. of house foundation
- ⑤ 1/4 corner lot. 2 & 3  
1 1/2" 6 in. x 12 in. rock, N. wheel trap, Westing Rd.  
Fence lines north & south. Information via local residence.  
Set brass S. C. Mon. on 1 in. pipe 6" below rd. surface  
N. 14° W., 29.39 ft. to a horiz. spike in 1 1/2" dia  
S. 73° 45' W., 108.85 ft. to a horiz. spike in 6" tall pole  
S. 78° S., 108.68 ft. to a horiz. spike in 6" tall pole  
N. 3° W., 19.39' to a horiz. spike in 4" fence post

LEGEND

MARSH	X
4" IRON PIPE	•
STATE BOUNDARY	-----
COUNTY LINE	-----
SECTION LINE	-----