



QUARTER COR.
SECTION COR.
TOWNSHIP COR.
PAVED RD.
GRAVEL RD.
DIRT RD.
PRIVATE CLAIM
BRIDGE
SURVEY POINT LOCATION

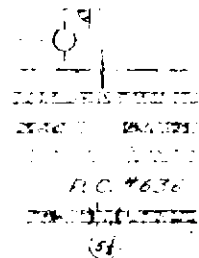

This is to certify that in January 1958, I made a survey of the Tract delineated hereon and that it is drawn in accordance with field notes of said survey.

W.L. PARRISON

REGISTERED CIVIL ENGINEER &
LAND SURVEYOR

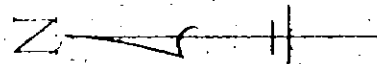

SCALE 1" = 800'

MICHIGAN DEPARTMENT OF CONSERVATION ENGINEERING AND ARCHITECTURE ADMINISTRATIVE SERVICES	
POINTE MOUILLEE BOUNDARY SURVEY MONUMENT DETAILS GAME DIVISION WAYNE-MONROE COUNTY	
APPROVED	 <small>ENGINEER IN CHARGE</small> <small>DATE</small>
APPROVED	<small>CHIEF OF SPONSORING DIVISION</small> <small>DATE</small>
APPROVED	<small>SEALED ENGINEER OR ARCHITECT</small> <small>DATE</small>
SURVEYED BY	W.L. PARRISON 1-58
DRAWN BY	A.V.M. AND A. SASABIGER 3-58
CHECKED BY	L. ... 5-58
	<small>REVISION</small> <small>DATE</small> <small>INITIAL</small>

E82A-17

