

LAND CORNER RECORDATION CERTIFICATE
Filing Requirement of Act 74, Mich. P.A. 1970

For corners in

WEXFORD

(County)

Located In:

Corner Code: //

- | | | | | |
|---------------------------------------|---|------|----|------------|
| 1. Public Land Survey | T | 21NR | 9W | B-13, C-13 |
| | T | R | | |
| | T | R | | |
| | T | R | | |
| 2. Property Controlling in Section | S | T | R | |
| | S | T | R | |
| 3. Miscellaneous Property in Sec. | S | T | R | |
| | S | T | R | |
| 4. Lot No. _____, Recorded Plat _____ | | | | |
| 5. Private Claims _____ | | | | |

Register of Deeds Stamp & File Number

I, **CARL F. ROSER**, in a field survey on **2-28**, 19**91**, do hereby certify that under requirements of P.A. 74, Michigan P.A. of 1970, the corner points mentioned in lines 1 and 2 above were in conformance with regulations and rules therefore as required in the current manual of survey instructions of the United States Department of the Interior, Bureau of Land Management or by a decree of a Court of Law and/or that the corner points mentioned in lines 3, 4 and 5 above were in conformance with the rules of the Michigan Board of Land Surveyors or by a Decree of a Court of Law, established, re-established, monumented, re-monumented, recovered, found as expressed below:

NOTE: Not more than 4 corners, all in the same town and range, may be recorded on this certificate.

A	B	C	D	E	F	G	H	I	J	K	L	M
2	6	5	4	3	2	1						
3												
4	7	8	9	10	11	12						
5												
6	18	17	16	15	14	13						
7												
8	19	20	21	22	23	24						
9												
10	30	29	28	27	26	25						
11												
12	31	32	33	34	35	36						
13												

A. Description of original monument and accessories and/or subsequent restoration:

B-13

C-13

B. Description of corner evidence found and/or method applied in restoring or reestablishing corner:

B-13

C-13


SET 1" PIPE FOR S1/4 S-31 FROM 3 FD MSHD WITS FROM 1963 SURVEY; PIPE IS IN OLD E-W B WIRE FN (FN ON GROUND). MSHD HAD SET 3/4" PIPE BY SINGLE PROPORTION IN 1963; NO EVIDENCE OF PIPE NOW.	FD 1-1/2" PIPE FOR SE COR S-31 AS SET BY MSHD IN 1963 US-131 RELOCATION SURVEY.
--	---

C. Description of monument for corner and accessories established to perpetuate locating the position of the corner:

B-13

C-13

PUSHED IN 1"x 8' GALV PIPE W/DNR CAP. SET CED POST. #15" MAPLE DUE N 62.83' 4" BALSAM N55°E 21.46' #15" TWIN MAPLE S45°E 45.14' 5" BALSAM S60°W 8.22' NE COR SEC 1 T20N R10W N89°11'E 236.4'	DROVE 1"x 8' GALV PIPE UNDERNEATH FD 1-1/2"x 30" PIPE; SET CED POST W/LOC TAG. 2"x 2" GALV ANGLE IRON FN POST DUE S 5.0' 3"ELM S70°E 38.24' 2"ELM DUE W 31.03' CTR RR TRACKS DUE E 149' N1/4 SEC 6 T20N R9W S89°12'W 65.87'
---	--

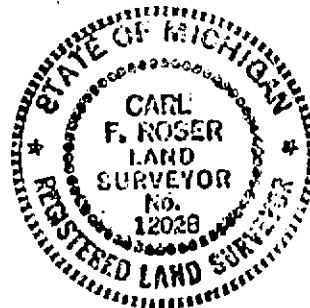

Signed by *Carl F. Roser* **03-16-91**

Date

Surveyor's Michigan License No. **12028**