

SURVEY & REMONUMENTATION

MAY 10 2000

LAND CORNER RECORDATION CERTIFICATE
Filing Requirement of Act 74, Mich. P.A. 1970

SECTION

For corners in

<u>WEXFORD COUNTY</u>	Located In:	Corner Code #
1. Public Land Survey	T <u>21N</u> R <u>09W</u>	<u>G-5</u>
	T _____ R _____	_____
	T _____ R _____	_____
	T _____ R _____	_____
2. Property Controlling in Section	S _____ T _____ R _____	_____
	S _____ T _____ R _____	_____
3. Miscellaneous Property in Sec.	S _____ T _____ R _____	_____
	S _____ T _____ R _____	_____

Richard D. Wilcox
WEXFORD COUNTY, MI
REGISTER OF DEEDS

RECEIVED
1999 DEC - 1 PM 3:06

Register of Deeds Stamp & File Number

4. Lot No. _____, Recorded Plat _____
5. Private Claims _____

1	A	B	C	D	E	F	G	H	I	J	K	L	M
2		6		5		4		3		2		1	
3													
4		7		8		9		10		11		12	
5													
6		18		17		16		15		14		13	
7													
8		19		20		21		22		23		24	
9													
10		30		29		28		27		26		25	
11													
12		31		32		33		34		35		36	
13													

I, George D. Smith, P.S., in a field survey on June, 19 99 do hereby state that under requirements of P.A. 74, Michigan P.A. of 1970, the corner points mentioned in lines 1 and 2 above were in conformance with regulations and rules therefore as required in the current manual of survey instructions of the United States Department of the Interior, Bureau of Land Management or by a decree of a Court of Law and /or that the corner points mentioned in lines 3, 4 and 5 above were in conformance with the rules of the Michigan Board of Land Surveyors or by a Decree of a Court of Law; established, re-established, monumented, recovered, found as expressed below:

NOTE: Not more than 2 corners, all in the same town and range, may be recorded on this certificate.

A. Description of original monument and accessories and/or subsequent restoration:

- G-5) 1848 GLO subdivision by Orson Lyon D.S. 8" Hemlock-N76½W-14, 13" Hemlock-N29½E-15.
- 1880 A. Teed Survey Liber 1, Page 25. Corner found no description or witnesses given.
- 1907 D Teed Survey Liber 1, Page 27. Old stake was graded out, reset by measuring to ¼ post north and south and putting it on straight line. 24" W. Pine-N75E-86.7', 36" W. Pine-S74½E-95.6', 24" W. Pine-N11½E-92.3',
- 1908 A. J. Teed Survey, Liber 1, Page 14. Gas pipe put in 1907 by D.E. Teed.
- 1962 MSHD Government monument witness recorded by G. Slattery, 1" iron shaft. East 75' and 125', tacked Hubs in fence line.
- 1966 Survey by G. Shadko for Michigan Department of Conservation (not recorded). Found 1" iron replaced with 4"x42" monument with brass cap, Oak 14"-S88W-99.40, Beech 11"-S82E-83.21.
- 1978 Wilcox PS #14102 Certificate of Survey. Found 1" iron shaft.
- 1980 Wilcox PS #14102 Certificate of Survey, Liber 1, Page 827. Found iron shaft witnesses same as 1962 MSHD.
- 1986 J. Ray PS #25869 Certificate of Survey, Liber 2, Page 218. Corner found no description or witnesses given.
- 1990 Carlson, PS #24589, LCRC Liber 4, Page 70. Found 4" brass cap in monument box 15.9' southeast of centerline US-131, 15" Beech-S81E-83.25', Fence post-S40E-121.62', 7" J. Pine-S70W-77.20', Tw 8" R. Pine-S87W-61.85'.
- 1995 J.D. Geers, PS #33977. Certificate of Survey Liber 74, Page 616. Found monument in monument box, S73W-69.75'-6" J. Pine, N75W-75.91'-4" J. Pine, S78E-82.69'-24" Beech, S58W-111.12'-3" Oak.

B. Description of corner evidence found and/or method applied in restoring or reestablishing corner:

- G-5) Found Department of Conservation 4" brass cap in monument box 16' East of centerline US 131 and one witness from Carlson PS #24589 LCRC Liber 4, Page 70. This corner is accepted as a careful and faithful re-establishment of the position of the original corner being the Section corner common to Section 9, 10, 16, T21N, R9W.

C. Description of monument for corner and accessories established to perpetuate locating the position of the corner:


- G-5) Department of Conservation 4" brass cap in monument box
- S73W 69.70 6" J. Pine (Found nail)
- N79E 183.90 18" R. Pine
- N67E 196.14 16" W. Pine
- S81E 124.11 28" Maple

Peer Group Reviewed and Approved

Date: 12 Nov 99
Richard D. Wilcox
Richard D. Wilcox, Wexford County Surveyor

LIBER 05 PAGE 171

Signed by _____
Surveyor's Michigan License No. _____

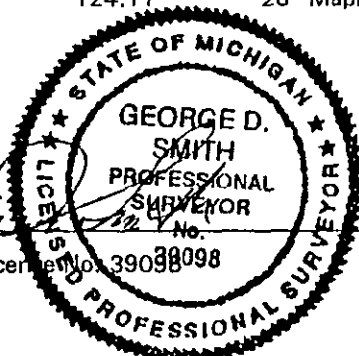

Date 11-12-99