

MAY 10 2000

RECEIVED

1999 DEC -3 PM 12: 43

SECTION

LAND CORNER RECORDATION CERTIFICATE  
Filing Requirement of Act 74, Mich. P.A. 1970

For corners in

*Linda Longmiller*  
WEXFORD COUNTY, MI  
REGISTERED RECORDS

<u>WEXFORD</u> (County)	Located In:	Corner Code #
1. Public Land Survey	T <u>21N</u> R <u>9W</u>	<u>G-8</u>
	T _____ R _____	_____
	T _____ R _____	_____
	T _____ R _____	_____
2. Property Controlling in Section	S _____ T _____ R _____	_____
	S _____ T _____ R _____	_____
3. Miscellaneous Property in Sec.	S _____ T _____ R _____	_____
	S _____ T _____ R _____	_____
4. Lot No. _____, Recorded Plat _____		
5. Private Claims _____		

Register of Deeds Stamp & File Number

1	A	B	C	D	E	F	G	H	I	J	K	L	M
2		6		5		4		3		2		1	
3													
4		7		8		9		10		11		12	
5													
6		18		17		16		15		14		13	
7													
8		19		20		21		22		23		24	
9													
10		30		29		28		27		26		25	
11													
12		31		32		33		34		35		36	
13													

I, CRAIG J. PULLEN, PS, in a field survey on JUNE 10, 1999, do hereby state that under requirements of P.A. 74, Michigan P.A. of 1970, the corner points mentioned in lines 1 and 2 above were in conformance with regulations and rules therefore as required in the current manual of survey instructions of the United States Department of the Interior, Bureau of Land Management or by a decree of a Court of Law and/or that the corner points mentioned in lines 3, 4 and 5 above were in conformance with the rules of the Michigan Board of Land Surveyors or by a Decree of a Court of Law; established, re-established, monumented, recovered, found as expressed below:

NOTE: Not more than 2 corners, all in the same town and range, may be recorded on this certificate.

A. Description of original monument and accessories and/or subsequent restoration:


- G-8 1848 G.L.O. SURVEY BY O. LYON, WOOD POST, BEECH S72W 27, BEECH 9 N32E 17
- 1887 FULLER SURVEY IN SECTION 21, NO WITNESSES OR CORNER DESCRIPTION GIVEN. DISTANCE TO NE CORNER - 2637.36'
- 1899 D. E. TEED SURVEY IN SECTION 21 NO WITNESSES OR CORNER DESCRIPTION GIVEN
- 1908 CAVANAGH SURVEY IN SECTION 22, STAKE LOST SET, DOUBLED DISTANCE OF 1/4 MILE AND SET NEW STAKE. PINE N72W 44, PINE N641/2E 47
- 1990 WADE-TRIM SURVEY IN SECTION 21 BY JAMES A. RAY PS#25869, L.C.R.C. L.4, P. 61, SET WEXFORD CO. MON. PER SURVEY BY TEED DATED APRIL 1899 RECORDED IN LIBER 1 PG 34. WEST POWER POLE 31.20, S80W 4" R. PINE 50.60', N40W STL. FE. POST 44.3', ON CL RD. & POWERLINE WEST.
- 1996 WADE-TRIM SURVEY IN SECTION 21 BY CRAIG J. PULLEN, PS #39095, L. 75, P. 952, COUNTY MONUMENT, WITNESSES SAME AS 1990 WADE-TRIM/GRANGER SURVEY
- 1997 3D SURVEYING SURVEY IN SECTION 21 BY DANIEL E. SCHRIPEMA PS#24617, L. 77, P. 371, E1/4 COR REC. LCRC L.4, P. 61, DISTANCE TO SE CORNER - 2639.86'
- 1999 MITCHELL & ASSOC. SURVEY IN SECTION 21, BY CAROL WAITE, PS #43074, WEXFORD CO. MON., WITNESSES SAME AS 1990 WADE-TRIM/GRANGER SURVEY

B. Description of corner evidence found and/or method applied in restoring or reestablishing corner:

- G-8 FOUND WEXFORD COUNTY MONUMENT (ALUMINUM) IN GOOD CONDITION, IN CENTERLINE OF 43 ROAD, 2' SOUTH OF FENCE TO WEST. LEFT AS IS AND STAMPED NEW CORNER INFORMATION. THIS CORNER IS ACCEPTED AS THE BEST AVAILABLE EVIDENCE OF THE POSITION OF THE CORNER.

C. Description of monument for corner and accessories established to perpetuate locating the position of the corner:

- G-8 1/4 CORNER COMMON TO SECTIONS 21 & 22, T21N, R9W
- WEXFORD COUNTY ALUMINUM MONUMENT STAMPED: 1/4, 21, 22, 1999, CJP, 39095
- N59°W FENCE POST 36.39'
- N88°W P. POLE 31.12'
- S80°W 9" RED PINE 50.93'
- N9°E SPIKE IN MAILBOX POST 95.00'

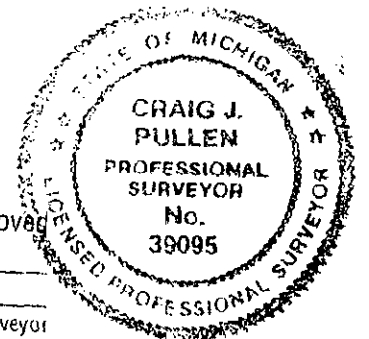

Peer Group Reviewed and Approved  
Date: 12 Nov 99  
*Richard D. Wilcox*  
Richard D. Wilcox, Wexford County Surveyor

igned by Craig J. Pullen

Date November 11, 1999

urveyor's Michigan License No. 39095