

**SURVEY & REMONUMENTATION**

**MAY 10 2000**

**RECEIVED**

**1999 DEC -3 PM 12: 43**

**SECTION**

**LAND CORNER RECORDATION CERTIFICATE**  
Filing Requirement of Act 74, Mich. P.A. 1970

*Linda Lougheed Miller*  
WEXFORD COUNTY, MI  
REGISTERED DEEDS

For corners in

<u>WEXFORD</u> (County)	Located In:	Corner Code #
1. Public Land Survey	T <u>21N</u> R <u>9W</u>	<u>G-9</u>
	T _____ R _____	_____
	T _____ R _____	_____
	T _____ R _____	_____
2. Property Controlling in Section	S _____ T _____ R _____	_____
	S _____ T _____ R _____	_____
3. Miscellaneous Property in Sec.	S _____ T _____ R _____	_____
	S _____ T _____ R _____	_____
4. Lot No. _____, Recorded Plat _____		
5. Private Claims _____		

Register of Deeds Stamp & File Number

	A	B	C	D	E	F	G	H	I	J	K	L	M
1													
2	6			5		4		3		2		1	
3													
4	7			8		9		10		11		12	
5													
6	18			17		16		15		14		13	
7													
8	19			20		21		22		23		24	
9													
10	30			29		28		27		26		25	
11													
12	31			32		33		34		35		36	
13													

I, CRAIG J. PULLEN, PS, in a field survey on JUNE 10, 1999, do hereby state that under requirements of P.A. 74, Michigan P.A. of 1970, the corner points mentioned in lines 1 and 2 above were in conformance with regulations and rules therefore as required in the current manual of survey instructions of the United States Department of the Interior, Bureau of Land Management or by a decree of a Court of Law and/or that the corner points mentioned in lines 3, 4 and 5 above were in conformance with the rules of the Michigan Board of Land Surveyors or by a Decree of a Court of Law; established, re-established, monumented, recovered, found as expressed below:

**NOTE: Not more than 2 corners, all in the same town and range, may be recorded on this certificate.**

**A. Description of original monument and accessories and/or subsequent restoration:**


- G-9 1848 G.L.O. RESURVEY BY O. LYON, WOOD POST, SUGAR TREE 20 S12 1/2E 21, SUGAR TREE 24 S23 1/2W 30
- 1887 FULLER SURVEY IN SECTION 21, NO CORNER DESCRIPTION GIVEN, HEM 12 S44E 86
- 1891 A. J. TEED SURVEY IN SECTION 28, LARGE STONE WITH SMALL STONE AROUND IT, NO WITNESSES GIVEN
- 1897 A. J. TEED SURVEY IN SECTION 27, GRADED OUT. RESET FROM FULLER'S WITNESSES.
- 1899 D. E. TEED SURVEY IN SECTION 21, STONE & STAKE, ELM 12 S33 1/2 E 71, ELM 10 N63E 66 1/2
- 1899 CAVANAGH SURVEY IN SECTION 22, NO WITNESSES OR CORNER DESCRIPTION GIVEN
- 1937 MDOT RIGHT-OF-WAY INFORMATION FOR M-115, PROJECT 83-22, SEC. COR. IS 23' N. & 16.05' W. OF TAN.
- 1990 WADE-TRIM/GRANGER SURVEY IN SECTION 21 BY J. RAY, PS #25869, FOUND WEXFORD COUNTY MONUMENT, N82°E T. POLE 52.30', N22°E POST AT TELE. PED. 64.24', S70°W FACE CON. PROJECT MARKER 86.95', S60°W CENTERLINE HIGHWAY M-115 16.4'
- 1991 JACK F. ERICKSON, PS #16929, L.C.R.C. L. 4, P. 111, MONUMENT BOX WITH 5/8" RE-ROD ABOVE CO. MONUMENT. NE EDGE M-115 AT INTERSECTION OF 43 ROAD (MCBAIN ROAD) N20°E 43.45' BACK CORNER CURB, N35°E 64.18' POLE WITH ELECTRIC BOX, N80°E 52.34' ST. LITE POLE, S60°E 23.88' BACK CORNER CURB
- 1997 3D SURVEYING SURVEY BY D. SCHRIPEMA PS#24617, L. 77, P. 371, SE SEC COR, REC LCRC-4, PG. 111
- 1999 MITCHELL & ASSOC. SURVEY IN SECTION 21 BY C. WAITE, PS #43074, FD. WEXFORD CO. MON., WITNESSES SAME AS 1990 WADE-TRIM/GRANGER SURVEY

**B. Description of corer evidence found and/or method applied in restoring or reestablishing corner:**

G-9 FOUND 5/8" IRON IN MONUMENT BOX 16.5' EAST OF CENTERLINE OF M-115 AND 3 PREVIOUS WITNESSES. ADDED WEXFORD COUNTY BRASS CAP. DISTNACE TO 1/4 TO NORTH IS 2640.00' (2642.64'-TEED). DISTANCE TO 1/4 TO WEST IS 2662.70' (2661.12'-TEED). DISTANCE TO 1/4 TO EAST IS 2652.14' (2648.58'-TEED). THIS CORNER IS ACCEPTED AS THE BEST AVAILABLE EVIDENCE OF THE POSITION OF THE ORIGINAL CORNER.

**C. Description of monument for corner and accessories established to perpetuate locating the position of the corner:**

- G-9 SECTION CORNER COMMON TO SECTIONS 21,22,27 &28, T21N, R9W
- 5/8" IRON WITH BRASS CAP STAMPED: 21,22,27, & 28, CJP, 39095, 1999
- N73°E POWER POLE 52.21'
- N31°E MDOT TAG IN GUARD POST FOR TEL. BOX 64.21'
- S71°W TOP CENTER CONCRETE R/W MARKER 87.01'
- S40°W POWER POLE 75.63'

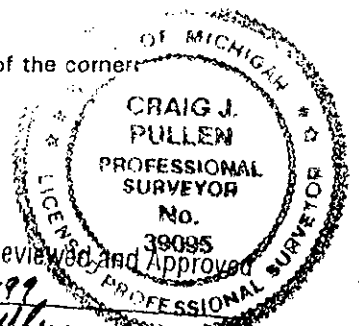

Peer Group Reviewed and Approved  
Date: 12 Nov 99  
*Richard D. Wilcox*  
Richard D. Wilcox, Wexford County Surveyor  
Date November 11, 1999

Signed by Craig J. Pullen

Surveyor's Michigan License No. 39095