

SURVEY & REMONUMENTATION

MAY 10 2000

SECTION

LAND CORNER RECORDATION CERTIFICATE
Filing Requirement of Act 74, Mich. P.A. 1970

RECEIVED

1999 DEC -3 PM 12: 43

Linda Laughmiller
WEXFORD COUNTY, MI
REGISTER OF DEEDS

For corners in

Form with fields for WEXFORD (County), Located In: (Town/Range), Corner Code #, and numbered sections 1-5 for survey details.

Register of Deeds Stamp & File Number

Grid table with columns A-M and rows 1-13 for recording deed information.

I, CRAIG J. PULLEN, PS, in a field survey on JUNE 10, 1999, do hereby state that under requirements of P.A. 74, Michigan P.A. of 1970, the corner points mentioned in lines 1 and 2 above were in conformance with regulations and rules therefore as required in the current manual of survey instructions of the United States Department of the Interior, Bureau of Land Management or by a decree of a Court of Law and/or that the corner points mentioned in lines 3, 4 and 5 above were in conformance with the rules of the Michigan Board of Land Surveyors or by a Decree of a Court of Law; established, re-established, monumented, recovered, found as expressed below:

NOTE: Not more than 2 corners, all in the same town and range, may be recorded on this certificate.

A. Description of original monument and accessories and/or subsequent restoration:

- List of survey records including G-10 1848 G.L.O. RESURVEY BY O. LYON, 1880 FULLER SURVEY, 1891 A. J. TEED SURVEY, 1897 A. J. TEED SURVEY, 1898 D. E. TEED SURVEY, 1972 WILCOX & ERICKSON SURVEY, 1976 J. ERICKSON, PS #16929 SURVEY, and 1988 WADE-TRIM/GRANGER SURVEY.


B. Description of corner evidence found and/or method applied in restoring or reestablishing corner:

G-10 FOUND 1" PIPE 5.5' EAST OF CENTERLINE OF 43 ROAD & 5' SOUTH OF FENCE TO WEST. DROVE 5/8" X 36" IRON INSIDE PIPE AND ADDED BRASS CAP. THIS CORNER IS ACCEPTED AS THE BEST AVAILABLE EVIDENCE OF THE POSITION OF THE ORIGINAL CORNER.

C. Description of monument for corner and accessories established to perpetuate locating the position of the corner:

- 3-10 1/4 CORNER COMMON TO SECTIONS 27 & 28, T21N, R9W
5/8"X36" IRON & BRASS CAP STAMPED: 1/4, 39095, 1999, 27, 28
N32°E POWER POLE 63.84'
S17°E 4" POPLAR 63.57'
N83°W POWER POLE 47.73'
N57°W 36" MAPLE 77.89'

Peer Group Reviewed and Approved
Date: 12 Nov 99
Richard D. Wilcox, Wexford County Surveyor

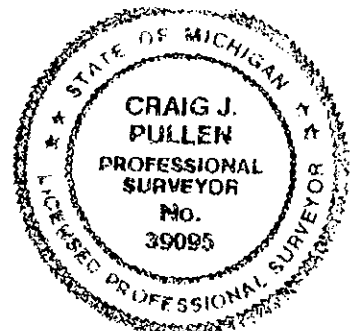

Signed by [Signature] Date November 11, 1999
Surveyor's Michigan License No. 39095