

SURVEY & REMONUMENTATION

MAY 10 2000

SECTION

LAND CORNER RECORDATION CERTIFICATE
Filing Requirement of Act 74, Mich. P.A. 1970

For corners in

RECEIVED
1999 DEC -3 PM 12: 43

Linda Loughmiller
WEXFORD COUNTY, MI
REGISTER OF DEEDS

| | | |
|---------------------------------------|--------------------------|---------------|
| <u>WEXFORD</u> (County) | Located In: | Corner Code # |
| 1. Public Land Survey | T <u>21N</u> R <u>9W</u> | <u>G-11</u> |
| | T _____ R _____ | _____ |
| | T _____ R _____ | _____ |
| | T _____ R _____ | _____ |
| 2. Property Controlling in Section | S _____ T _____ R _____ | _____ |
| | S _____ T _____ R _____ | _____ |
| 3. Miscellaneous Property in Sec. | S _____ T _____ R _____ | _____ |
| | S _____ T _____ R _____ | _____ |
| 4. Lot No. _____, Recorded Plat _____ | | |
| 5. Private Claims _____ | | |

Register of Deeds Stamp & File Number

| | | | | | | | | | | | | | |
|----|---|----|---|----|---|----|---|----|---|----|---|----|---|
| 1 | A | B | C | D | E | F | G | H | I | J | K | L | M |
| 2 | | 6 | | 5 | | 4 | | 3 | | 2 | | 1 | |
| 3 | | | | | | | | | | | | | |
| 4 | | 7 | | 8 | | 9 | | 10 | | 11 | | 12 | |
| 5 | | | | | | | | | | | | | |
| 6 | | 18 | | 17 | | 16 | | 15 | | 14 | | 13 | |
| 7 | | | | | | | | | | | | | |
| 8 | | 19 | | 20 | | 21 | | 22 | | 23 | | 24 | |
| 9 | | | | | | | | | | | | | |
| 10 | | 30 | | 29 | | 28 | | 27 | | 26 | | 25 | |
| 11 | | | | | | | | | | | | | |
| 12 | | 31 | | 32 | | 33 | | 34 | | 35 | | 36 | |
| 13 | | | | | | | | | | | | | |

I, CRAIG J. PULLEN, PS, in a field survey on JUNE 10, 1999, do hereby state that under requirements of P.A. 74, Michigan P.A. of 1970, the corner points mentioned in lines 1 and 2 above were in conformance with regulations and rules therefore as required in the current manual of survey instructions of the United States Department of the Interior, Bureau of Land Management or by a decree of a Court of Law and/or that the corner points mentioned in lines 3, 4 and 5 above were in conformance with the rules of the Michigan Board of Land Surveyors or by a Decree of a Court of Law; established, re-established, monumented, recovered, found as expressed below:

NOTE: Not more than 2 corners, all in the same town and range, may be recorded on this certificate.

A. Description of original monument and accessories and/or subsequent restoration:


- G-11 1848 G.L.O. RESURVEY BY O. LYON, WOOD POST, BEECH 8 S1W 15, HEMLOCK 15 N43 3/4W 19
- 1890 A. J. TEED SURVEY IN SECTION 33, FD. STAKE BY MEASUREMENTS FROM STA. TREE AND M. P., NW COR. OF STONE S50 1/2 E 79L
- 1891 A. J. TEED SURVEY IN SECTION 28, NO WITNESSES, CORNER SHOWN AS IN.
- 1968 PLAT OF EVERGREEN ESTATES, L. 5 OF PLATS, P. 193 BY ROBERT H. HINKLEY, PS #13730, SW COR. OF SECTION IS 5' SOUTH OF P.O.B. OF PLAT
- 1972 JAMES H. GRANGER PS#16041 L.C.R.C. LIBER 1, PAGE 159. FD. 1/2" IRON PIPE FROM INFORMATION ON PLAT IN SECTION 27. NW'LY CORNER OF HOUSE S80°E 53.2', W'LY CORNER OF HOUSE S50°E 52.3', SIGN POST S75°W 51.5'
- 1979 JEROME D. SWITALSKI, PS#13045, SURVEY IN SECTION 33, L.1, P. 743, FD. 1/2" PIPE NO WITNESSES GIVEN

B. Description of corner evidence found and/or method applied in restoring or reestablishing corner:

G-11 FD. 1/2" X 18" IRON & CAP (NOT LEGIBLE) 0.5' WEST OF CENTERLINE OF 43 ROAD, 3' NORTH OF CENTERLINE OF 50 ROAD AND 1 PREVIOUS WITNESS. REPLACED WITH 5/8" X 36" IRON WITH WEXFORD COUNTY BRASS CAP. THIS CORNER IS ACCEPTED AS THE BEST AVAILABLE EVIDENCE OF THE POSITION OF THE ORIGINAL CORNER.

C. Description of monument for corner and accessories established to perpetuate locating the position of the corner:

- B-11 SECTION CORNER COMMON TO SECTIONS 27,28,33 & 34, T21N, R9W
- 5/8"X36" IRON & BRASS CAP STAMPED: 27,28,33 & 34, 39095, 1999, T21N, R9W
- N40°E 12" RED PINE 53.74'
- S71°E NW COR. HSE. (#11023) FOUNDATION 55.30'
- S74°W 10" SPRUCE 97.91'
- N61°W NAIL & TAG IN P. POLE 69.55'

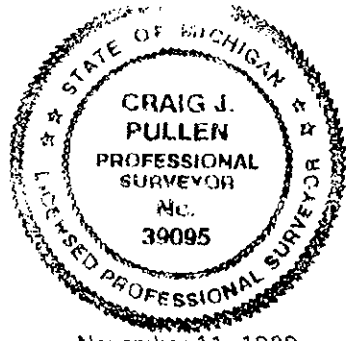

Peer Group Reviewed and Approved
Date: 12 Nov 99
Richard D. Wilcox
Richard D. Wilcox, Wexford County Surveyor

igned by Craig J. Pullen

Date November 11, 1999

Surveyor's Michigan License No. 39095