

**SURVEY  
REMONUMENTATION**

MAY 10 2000

**SECTION**

**LAND CORNER RECORDATION CERTIFICATE  
Filing Requirement of Act 74, Mich. P.A. 1970**

RECEIVED

1999 DEC -3 PM 12: 43

*Linda Laughmiller*  
WEXFORD COUNTY, MI  
REGISTERED DEEDS

For corners in

<u>WEXFORD</u> <small>(County)</small>	Located In:	Corner Code #
1. Public Land Survey	T <u>21N</u> R <u>9W</u>	<u>G-12</u>
	T _____ R _____	_____
	T _____ R _____	_____
	T _____ R _____	_____
2. Property Controlling in Section	S _____ T _____ R _____	_____
	S _____ T _____ R _____	_____
3. Miscellaneous Property in Sec.	S _____ T _____ R _____	_____
	S _____ T _____ R _____	_____
4. Lot No. _____, Recorded Plat _____		
5. Private Claims _____		

**Register of Deeds Stamp & File Number**

1	A	B	C	D	E	F	G	H	I	J	K	L	M
2		6		5		4		3		2		1	
3													
4		7		8		9		10		11		12	
5													
6		18		17		16		15		14		13	
7													
8		19		20		21		22		23		24	
9													
10		30		29		28		27		26		25	
11													
12		31		32		33		34		35		36	
13													

I, CRAIG J. PULLEN, PS, in a field survey on JUNE 10, 1999, do hereby state that under requirements of P.A. 74, Michigan P.A. of 1970, the corner points mentioned in lines 1 and 2 above were in conformance with regulations and rules therefore as required in the current manual of survey instructions of the United States Department of the Interior, Bureau of Land Management or by a decree of a Court of Law and/or that the corner points mentioned in lines 3, 4 and 5 above were in conformance with the rules of the Michigan Board of Land Surveyors or by a Decree of a Court of Law; established, re-established, monumented, recovered, found as expressed below:

**NOTE: Not more than 2 corners, all in the same town and range, may be recorded on this certificate.**

**A. Description of original monument and accessories and/or subsequent restoration:**

- G-12 1848 G.L.O. RESURVEY BY O. LYON, WOOD POST, HEMLOCK 15 S60W 9, HEMLOCK 20 S64E 26
- 1887 A. J. TEED SURVEY IN SECTION 33. FOUND BOTH WTNSS TREES SET NEW STAKE
- 1890 A. J. TEED SURVEY IN SECTION 33. FOUND STAKE SET IN 1887


**B. Description of corner evidence found and/or method applied in restoring or reestablishing corner:**

G-12 FOUND 1/2" IRON & CAP (NOT LEGIBLE) IN CENTERLINE OF 43 ROAD AND IN LINE WITH FENCE EAST & WEST, AND 33 FEET EAST OF CORNER FENCE POST AT RIGHT-OF-WAY. SET 5/8" X 36" WITH BRASS CAP IN IT'S PLACE. ALSO FOUND 5/8" IRON (NO CAP) 5.12' SOUTH (NOT ACCEPTED - REMOVED). THIS POSITION ALSO FITS 1/8 LINE FENCE TO SOUTH. THIS CORNER IS ACCEPTED AS THE BEST AVAILABLE EVIDENCE OF THE POSITION OF THE ORIGINAL CORNER.

**C. Description of monument for corner and accessories established to perpetuate locating the position of the corner:**

- G-12 1/4 CORNER COMMON TO SECS. 33 & 34, T21N, R9W
- 5/8" X 36" IRON & BRASS CAP STAMPED: 1999, CJP, 39095, 1/4, 33, 34
- N55°W POWER POLE 48.67'
- N29°W 10" APPLE 53.13'
- N48°E 7" MAPLE 37.02'
- S77°E 14" POPLAR 49.37'
- N88°E CORNER FENCE POST 33.8'

Peer Group Reviewed and Approved  
Date: 12 Nov 99  
*Richard D. Wilcox*  
Richard D. Wilcox, Wexford County Surveyor

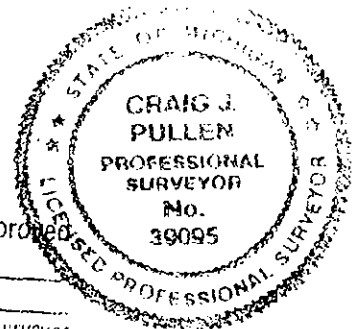

igned by *Craig J. Pullen* Date November 12, 1999  
urveyor's Michigan License No. 39095