

APR 16 1999

RECEIVED

1998 DEC 30 AM 10:18

SECTION

LAND CORNER RECORDATION CERTIFICATE  
Filing Requirement of Act 74, Mich. P.A. 1970

*Linda Laughmiller*  
WEXFORD COUNTY, MI  
REGISTER OF DEEDS

For corners in

<u>WEXFORD</u> (County)	Located In:	Corner Code #
1. Public Land Survey	T <u>21N</u> R <u>9W</u>	<u>H-13</u>
	T _____ R _____	_____
	T _____ R _____	_____
	T _____ R _____	_____
2. Property Controlling in Section	S _____ T _____ R _____	_____
	S _____ T _____ R _____	_____
3. Miscellaneous Property in Sec.	S _____ T _____ R _____	_____
	S _____ T _____ R _____	_____
4. Lot No. _____, Recorded Plat _____		
5. Private Claims _____		

Register of Deeds Stamp & File Number

I, CRAIG J. PULLEN, PS, in a field survey on OCTOBER 7, 1998, do hereby state that under requirements of P.A. 74, Michigan P.A. of 1970, the corner points mentioned in lines 1 and 2 above were in conformance with regulations and rules therefore as required in the current manual of survey instructions of the United States Department of the Interior, Bureau of Land Management or by a decree of a Court of Law and/or that the corner points mentioned in lines 3, 4 and 5 above were in conformance with the rules of the Michigan Board of Land Surveyors or by a Decree of a Court of Law; established, re-established, monumented, recovered, found as expressed below:

NOTE: Not more than 2 corners, all in the same town and range, may be recorded on this certificate.

A	B	C	D	E	F	G	H	I	J	K	L	M
1												
2	6		5		4		3		2		1	
3												
4	7		8		9		10		11		12	
5												
6	18		17		16		15		14		13	
7												
8	19		20		21		22		23		24	
9												
10	30		29		28		27		26		25	
11												
12	31		32		33		34		35		36	
13												

A. Description of original monument and accessories and/or subsequent restoration:


H-13 1838 G.L.O. SURVEY BY J. BRINK, WOOD POST, BEECH 20 N38W 82, SUGAR 16 N80E 30

B. Description of corner evidence found and/or method applied in restoring or reestablishing corner:

H-13 FOUND 1/2" IRON & CAP (NOT LEGIBLE) 2.5' NORTH OF THE CENTERLINE OF 52 ROAD AND 142.3' EAST OF CENTERLINE OF 150TH AVENUE. THE IRON IS ON LINE BETWEEN THE SW CORNER AND SE CORNER OF SECTION 34 AND 0.18' WEST OF MIDWAY. REPLACED 1/2" IRON WITH 5/8" X 36" IRON & BRASS CAP. THIS CORNER IS ACCEPTED AS THE BEST AVAILABLE EVIDENCE OF THE POSITION OF THE CORNER.

C. Description of monument for corner and accessories established to perpetuate locating the position of the corner:

H-13 SOUTH 1/4 CORNER OF SECTION 34, T21N, R9W  
 5/8" X 36" IRON WITH BRASS CAP STAMPED: CJP, 39095, 1998, 34, 1/4  
 N29°E 4" SCOTCH PINE 64.49'  
 S20°E TWIN 8" POPLAR 61.19'  
 S1°W 6" BOX ELDER 54.35'  
 S51°W TWIN 9" POPLAR 45.71'

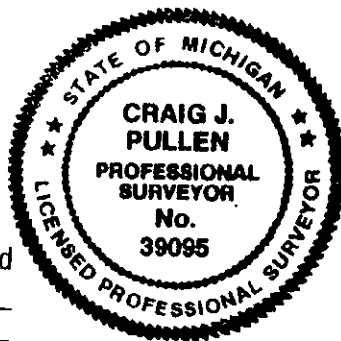

Peer Group Reviewed and Approved  
 Date: 30 Oct 98  
*Richard D. Wilcox*  
 Richard D. Wilcox, Wexford County Surveyor

Signed by *Craig J. Pullen*

Date NOVEMBER 6, 1998

Surveyor's Michigan License No. 39095