

**SURVEY &
REMONUMENTATION**

MAY 10 2000

SECTION

**LAND CORNER RECORDATION CERTIFICATE
Filing Requirement of Act 74, Mich. P.A. 1970**

For corners in

<u>WEXFORD</u> (County)	Located In:	Corner Code #
1. Public Land Survey	T <u>21N</u> R <u>9W</u>	<u>1-8</u>
	T _____ R _____	_____
	T _____ R _____	_____
	T _____ R _____	_____
2. Property Controlling in Section	S _____ T _____ R _____	_____
	S _____ T _____ R _____	_____
3. Miscellaneous Property in Sec.	S _____ T _____ R _____	_____
	S _____ T _____ R _____	_____
4. Lot No. _____, Recorded Plat _____		
5. Private Claims _____		

RECEIVED
1999 DEC -3 PM 12: 43

Linda Laughmiller
WEXFORD COUNTY, MI
REGISTER OF DEEDS

Register of Deeds Stamp & File Number

I, CRAIG J. PULLEN, PS, in a field survey on October 21, 1999, do hereby state that under requirements of P.A. 74, Michigan P.A. of 1970, the corner points mentioned in lines 1 and 2 above were in conformance with regulations and rules therefore as required in the current manual of survey instructions of the United States Department of the Interior, Bureau of Land Management or by a decree of a Court of Law and/or that the corner points mentioned in lines 3, 4 and 5 above were in conformance with the rules of the Michigan Board of Land Surveyors or by a Decree of a Court of Law; established, re-established, monumented, recovered, found as expressed below:

NOTE: Not more than 2 corners, all in the same town and range, may be recorded on this certificate.

1	A	B	C	D	E	F	G	H	I	J	K	L	M
2		6		5		4		3		2		1	
3													
4		7		8		9		10		11		12	
5													
6		18		17		16		15		14		13	
7													
8		19		20		21		22	●	23		24	
9													
10		30		29		28		27		26		25	
11													
12		31		32		33		34		35		36	
13													

A. Description of original monument and accessories and/or subsequent restoration:


- I-8 1848 G.L.O. RESURVEY BY O. LYON, SET WOOD POST ELM 16 N30E 4, SUGAR TREE 8 S58W 42
- 1883 A. J. TEED SURVEY IN SECTION 23, CORNER SHOWN AS IN, NO WITNESSES GIVEN
- 1902 D. E. TEED SURVEY IN SECTION 22, FOUND POINT OF OLD STAKE, PUT IN CEDAR WITH STONE ON TOP, FENCE POST N88 1/2 W 46
- 1908 CAVANAGH SURVEY IN SECTION 22, FOUND STAKE, FENCE POST N88 1/2 W 46L, TEL. POLE S44E 54 1/2, TEL. POLE S87 1/2 W 25

B. Description of corner evidence found and/or method applied in restoring or reestablishing corner:

- I-8 NO PREVIOUS CORNER EVIDENCE OR WITNESSES WERE FOUND. THE POSITION OF THE CORNER WAS RE-ESTABLISHED BY SINGLE PROPORTIONATE MEASUREMENT. SET 5/8" X 36" IRON AND BRASS CAP HALFWAY AND ON LINE BETWEEN SECTION CORNERS TO THE NORTH AND SOUTH. DISTANCE TO SECTION CORNERS NORTH AND SOUTH IS 2645.13'. THIS CORNER IS ACCEPTED AS A CAREFUL AND FAITHFUL RE-ESTABLISHMENT OF THE POSITION OF THE ORIGINAL CORNER.

C. Description of monument for corner and accessories established to perpetuate locating the position of the corner:

- I-8 1/4 CORNER COMMON TO SECTIONS 22 & 23, T21N, R9W
- 5/8" X 36" IRON IN MONUMENT BOX STAMPED: 1/4, 22, 23, CJP, 1999, 39095
- N13°W POWER POLE 144.24'
- N42°E P.K. NAIL IN N'LY END OF 12" CMP 21.38'
- EAST P.K. NAIL IN S'LY END OF 12" CMP 27.25'
- S88°E 28" TWIN MAPLE 63.18'

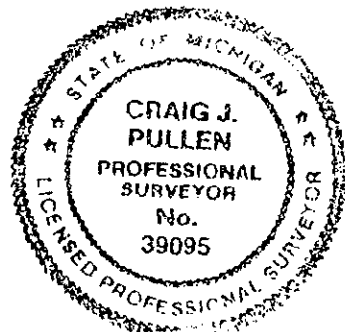

Peer Group Reviewed and Approved

Date: 12 Nov 99
Richard D. Wilcox
Richard D. Wilcox, Wexford County Surveyor

Signed by *Craig J. Pullen*

Date November 11, 1999

Surveyor's Michigan License No. 39095